

CODED

MISSISSIPPI
 BOARD OF WATER COMMISSIONERS
 416 North State Street
 Jackson, Mississippi 39201

Smith
 B 8
 8-16-68

WATER WELL DRILLERS LOG

Smith
 Covington
 county well located

8.16.68 date well completed
 Ray West firm name

LANDOWNER: Tonnie L Rayford
Rt 1
Pulaski Miss
 (mailing address)

description of formations encountered	from	to
<u>Sandy Clay</u>	<u>0</u>	<u>25</u>
<u>Blue clay</u>	<u>25</u>	<u>70</u>
<u>hard</u>	<u>70</u>	<u>100</u>

WELL LOCATION:
 sec. 9 T 4 N R 7 E
8 miles SW of Raleigh Miss
 (distance) (direction) (nearest town)

WELL PURPOSE: home
 (home, irrigation, municipal, industrial)


CODED

- WELL COMPLETION DATA:
- (1) diameter (inches) 2
 - (2) total depth (feet) 100
 - (3) static water level (feet) 60 ^{below}/_{above} top of ground.
 - (4) casing galv 95
 (material) (depth)
 _____ if telescope see back.
 (size)
 - (5) screen 30 90
 (length) (depth to top)
1 1/4 St Steel
 (size) (material)
 - (6) pump 1/2 4
 (HP) (yield gpm)
 - (7) electric log no
 (yes or no)

(organization running log)


(8) how well bottom plugged washed

DRILLERS REMARKS:

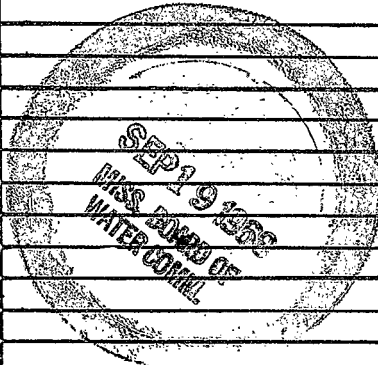

If well telescopes please sketch and show depths.

GROUND LEVEL

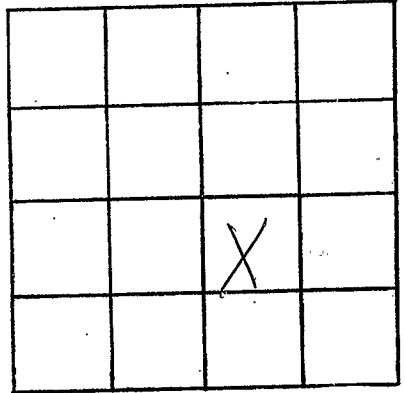

SECTION 9

Please indicate well location X.

ADDITIONAL INFORMATION

If more than one screen, show locations of each on sketch.