

130

Smith
B9
8-6-68

MISSISSIPPI
BOARD OF WATER COMMISSIONERS
416 North State Street
Jackson, Mississippi 39201

WATER WELL DRILLERS LOG

8-6 1968 Frank Dunning Sew Smith
date well completed firm name county well located

CODED

CODED

CODED

CODED

LANDOWNER: R.H. Baker
Calvin
Miss
(mailing address)

WELL LOCATION:
sec. 26 T 4 N R 7 E
2 miles N of BURNS
(distance) (direction) (nearest town)

WELL PURPOSE: Home
(home, irrigation, municipal, industrial)

WELL COMPLETION DATA:

- (1) diameter (inches) 2"
- (2) total depth (feet) 1066
- (3) static water level (feet) 257 below above top of ground.
- (4) casing Galv 1057
(material) (depth)
2"
(size) if telescope see back.
- (5) screen 15 1051
(length) (depth to top)
2" Stainless Steel
(size) (material)
- (6) pump 5 HP 15
(HP) (yield gpm)
Elect
(type power)
- (7) electric log No
(yes or no)

(organization running log)
- (8) how well bottom plugged Backwash
Water

description of formations encountered	from	to
Clay + bed Sand	0	20
Clay		122
Fine Sand + 5ths Clay		140
Clay		201
Shale		410
Shale + 5th rock		492
Shale		522
Fine Sand + 5th Clay		532
Soft Shale		552
Whiskey Sand		573
Fine Sand		594
Fine Sand + 5th Clay		615
Soft Shale + 7 Sand		635
Shale		655
Sand + 5th 7 Sand		690
Fine Sand		695
Shale + 5th 7 Sand		717
Shale		758
Shale + Rock		818
Hard Rock		824
Shale + Rock		838
Shale		912
Shale + 5th 4 Sand		943
Shale		964
Shale + 5th 7 Sand		985
Fine Sand + Shale		1017
Fine Sand		1027
Fine Sand + 5th Clay		1048
Fine Sand		1066
Clay		1079

CODED

CODED

CODED


JAN - 8 1969

MISS. BD. OF
WATER COMMISSIONERS

DRILLERS REMARKS:

If well telescopes please sketch and show depths.

GROUND LEVEL

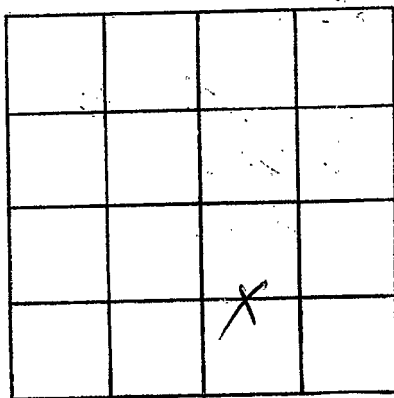

SECTION 26

Please indicate well location X.

ADDITIONAL INFORMATION

If more than one screen,
show locations of each on sketch.