

Smith
B10
2 - 69

MISSISSIPPI
BOARD OF WATER COMMISSIONERS
416 North State Street
Jackson, Mississippi 39201

CODED

WATER WELL DRILLERS LOG

Feb 19 69 Wilkerson Drilling Smith
date well completed firm name county well located

LANDOWNER: Jeff Loftin

description of formations encountered

from

to

PULASKI MISS
(mailing address)

Red clay	0	15
Red sand	15	20
Brown clay	20	40
Rock	40	41
SAND	41	80

WELL LOCATION:

sec. 16 T 4 N R 7 E
S W
4 1/2 miles N-W of Trenton
(distance) (direction) (nearest town)

WELL PURPOSE: home
(home, irrigation, municipal, industrial)

WELL COMPLETION DATA:

- (1) diameter (inches) 2
- (2) total depth (feet) 76
- (3) static water level (feet) 60 below above top of ground.
- (4) casing GALV 71
(material) (depth)
If telescope see back.
(size)
- (5) screen 5 76
(length) (depth to top)
2 STAINLESS STEEL
(size) (material)
- (6) pump 3/4 6
(HP) (yield gpm)
5/100
(type power)
- (7) electric log NO
(yes or no)
(organization running log)
- (8) how well bottom plugged 2" BULL

CODED


DRILLERS REMARKS:

MAR 5 1969

MISS. BD. OF
WATER COM.

If well telescopes please sketch and show depths.

GROUND LEVEL

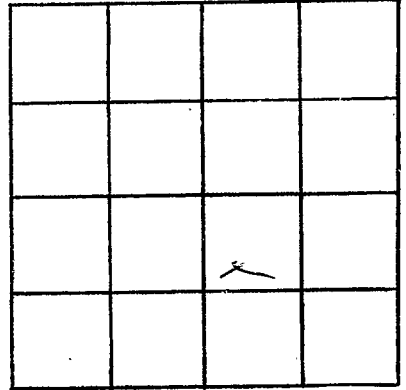

SECTION 16

Please indicate well location X.

ADDITIONAL INFORMATION

If more than one screen,
show locations of each on sketch.