

Smith
B 11
9-25-69

MISSISSIPPI
BOARD OF WATER COMMISSIONERS
416 North State Street
Jackson, Mississippi 39201

CODED
CODED

WATER WELL DRILLERS LOG

Sept. 25 1969 W. J. Butler Smith
date well completed firm name county well located

LANDOWNER: Irvin Bradshaw
Pulzski, Rt. 1
Miss.
(mailing address)

Description of formations encountered	from	to
Clay	0	20
Sand & clay	20	30
Clay & Rock	30	40
Clay	40	60
Sand, w/ nitro + rock	60	70
Clay & Rock	70	80
Clay	80	90
Sand + Clay	90	110
nitro - sand	110	120
sand	120	140
Clay & Sand	140	160

WELL LOCATION: 7
sec 29 T. 4 S. R. 4 E. W.
1/4 miles E of Tredon
(distance) (direction) (nearest town)

WELL PURPOSE: Home
(home, irrigation, municipal, industrial)

WELL COMPLETION DATA:

- (1) diameter (inches) 2"
- (2) total depth (feet) 160'
- (3) static water level (feet) _____ below above top of ground.
- (4) casing galv., 126'
(material) (depth)
2" if telescope see back.
(size)
- (5) screen 10', 126'
(length) (depth to top)
2", S. Steel
(size) (material)
- (6) pump _____ (HP) _____ (yield gpm)
(type power)
- (7) electric log NO
(yes or no)
(organization running log)
- (8) how well bottom plugged 2" BWV


DRILLERS REMARKS:

DEC 15 1969

MISS. DIV. OF WATER CONTROL

If well telescopes please sketch and show depths.

GROUND LEVEL

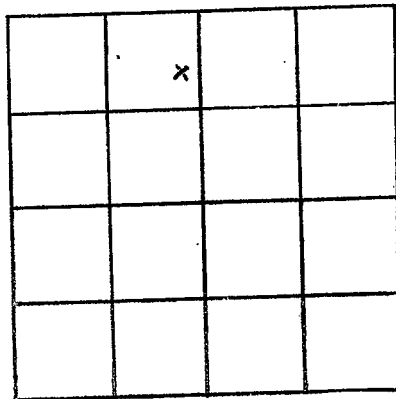

SECTION 29

Please indicate well location X.

ADDITIONAL INFORMATION

If more than one screen, show locations of each on sketch.