

Smith
B 12
5-12-70

MISSISSIPPI
BOARD OF WATER COMMISSIONERS
416 North State Street
Jackson, Mississippi 39201

WATER WELL DRILLERS LOG

5-12 date well completed 1970 W. H. Barnes Water well Smith firm name county well located

LANDOWNER: Foster Pady
Route 1
Pulaski Miss.
(mailing address) 073

WELL LOCATION:
sec. 4 T# S R. 7
6 miles W of Sorens
(distance) (direction) (nearest town)

WELL PURPOSE: Home use
(home, irrigation, municipal, industrial)

WELL COMPLETION DATA:
(1) diameter (inches) 2
(2) total depth (feet) 125
(3) static water level (feet) 17 below above top of ground.
(4) casing Galv. (material) (depth)
1 1/2 (size) if telescope see back.
(5) screen 80 gauge (length) St-1 (depth to top)
80 gauge (size) Stainless (material)
(6) pump 1 (HP) 15 (yield gpm)
Elec. (type power)
(7) electric log no (yes or no)
(organization running log)
(8) how well bottom plugged Well valve

description of formations encountered	from	to
Red Clay	0	5
yellow clay	5	16
yellow sand	16	24
Blue Clay	24	47
Fine Blue sand	47	48
Blue Clay	48	84
Fine Blue sand	84	91
Blue Clay	91	116
Fine Blue sand	116	125


JUN 4 1970

DRILLERS REMARKS:

MISS. BD. OF
WATER COMM.

If well telescopes please sketch and show depths.

GROUND LEVEL

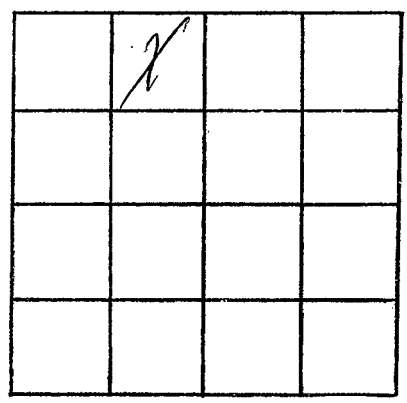

SECTION 7

Please indicate well location X.

ADDITIONAL INFORMATION

A series of horizontal lines for writing additional information.

If more than one screen, show locations of each on sketch.