

SMITH
B13
7-14-70

MISSISSIPPI
BOARD OF WATER COMMISSIONERS
416 North State Street
Jackson, Mississippi 39201

CODED

WATER WELL DRILLERS LOG

July 14 1970 date well completed
10 Wilkerson Drilling Co. firm name
Smith county well located

LANDOWNER:
Billie R. Black
Pulaski, Miss
(mailing address)

description of formations encountered	from	to
yellow clay	0	20
sandy yellow clay	20	30
blue clay	30	63
sand & blue clay	63	73
layers of sand & clay	73	95
blue clay	95	115
Water B. Layer	115	126

WELL LOCATION:
sec. 3 T. 4 N. R. 1 E.
6 miles SSE of Pulaski
(distance) (direction) (nearest town)

WELL PURPOSE: Home
(home, irrigation, municipal, industrial)

WELL COMPLETION DATA:

- (1) diameter (inches) 2
- (2) total depth (feet) 126
- (3) static water level (feet) 91 below above top of ground.
- (4) casing galv. (material), 126 (depth),
2 if telescope see back. (size)
- (5) screen 4 (length), 126 (depth to top),
2 (size), S. Steel (material)
- (6) pump 1 (HP), 7 (yield gpm),
Elec. (type power)
- (7) electric log no (yes or no)
no (organization running log)
- (8) how well bottom plugged B.M.C.

CODED


AUG 17 1970

DRILLERS REMARKS:

MISS. Bd. of
WATER

If well telescopes please sketch and show depths.

GROUND LEVEL

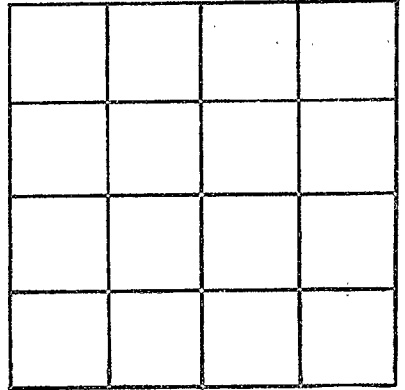

SECTION _____

Please indicate well location X.

ADDITIONAL INFORMATION

If more than one screen, show locations of each on sketch.