

MISSISSIPPI DEPARTMENT OF NATURAL RESOURCES

Bureau of Land and Water Resources

Southport Mall

P.O. Box 10631

CODÉD

Jackson, Mississippi 39209

WATER WELL DRILLERS LOG

Griner Drilling Service, Inc.

Smith

SMITH
B 21

251B

6-13-91

date well completed

firm name

county well located

LANDOWNER:	description of formations encountered	from	to
Howell Petroleum Corp. Ten Ten Lamar, Suite 1800 Houston, Texas 77002 (mailing address)			
WELL LOCATION: 2462'S & 1067'E sec. 2 T. 4N R. 7E of Homewood (distance) (direction) (nearest town)	clay, rock	30	600
WELL PURPOSE: oilfield rig (home, irrigation, municipal, industrial)	sand, some clay	600	660
WELL COMPLETION DATA:			
(1) diameter (inches) 4"			
(2) total depth (feet) 800'			
(3) static water level (feet) 120' below top of ground.			
(4) casing PVC 600' (material) (depth)			
4" (size) if telescope see back.			
(5) screen 60' 600' to 660' (length) (depth to top)			
4" PVC screen (size) (material)			
(6) pump 90 (HP) (yield gpm)			
Air Compressor (type power)			
(7) electric log (yes or no)			
(organization running log)			
(8) how well bottom plugged 4" Back Wash Valve			

Lease: No. 1 King


RECEIVED
JUL 08 1991

Dept. of Environmental Quality
Bureau of Land & Water Resources

DRILLERS REMARKS:

If well telescopes please sketch and show depths.

GROUND LEVEL

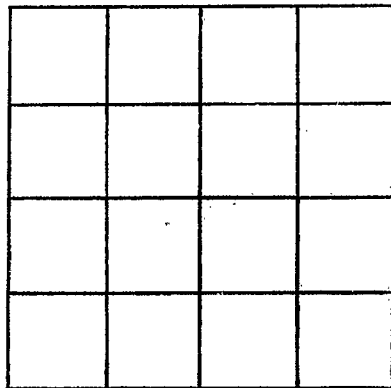

SECTION _____

Please indicate well location X.

ADDITIONAL INFORMATION

If more than one screen,
show locations of each on sketch.