

MISSISSIPPI DEPARTMENT OF NATURAL RESOURCES

Bureau of Land and Water Resources

Southport Mall

P.O. Box 10631

251D

Jackson, Mississippi 39209

WATER WELL DRILLERS LOG

SMITH
B 22

CODED

Griner Drilling Service, Inc.

Smith

7-3-96
date well completed

Griner Drilling Service, Inc.
firm name

Smith
county well located

Lease: No. 1 Allen P. Kearney

LANDOWNER:

Norcen Explorer, Inc.
550 Westlake Blvd.
Suite 350
Houston, TX 77079

description of formations encountered

from

to

sand

0 10

clay

10 580

sand

580 630


WELL LOCATION:

sec. 35 T 4 N R 7 E
Burns
(distance) miles (direction) of (nearest town)

WELL PURPOSE: oilfield rig supply
(home, irrigation, municipal, industrial)

WELL COMPLETION DATA:

- (1) diameter (inches) 3"
- (2) total depth (feet) 630'
- (3) static water level (feet) 120' below top of ground.
- (4) casing PVC 580'
(material) (depth)
3"
(size) if telescope see back.
- (5) screen 50' 580' to 630'
(length) (depth to top)
3" PVC screen
(size) (material)
- (6) pump 80
(HP) (yield gpm)
A/C
(type power)
- (7) electric log (yes or no)
(organization running log)
- (8) how well bottom plugged or
3" backwash valve

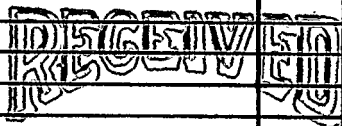


OCT 23 1996

Dept. of Environmental Quality
Bureau of Land & Water Resources

DRILLERS REMARKS:

If well telescopes please sketch and show depths.

GROUND LEVEL

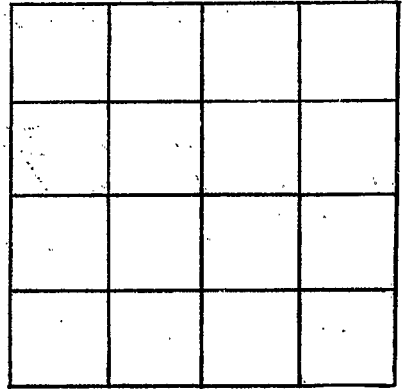

SECTION _____

Please indicate well location X.

ADDITIONAL INFORMATION

If more than one screen,
show locations of each on sketch.