r	State W	'ell Report			
County: SMITH		art 1	For Office Use Only:		
County:	Mississippi Department of Environmental Quality		Aquifer:		
Permit #:	Office of Land a	and Water Resources	Well #: B -3 a)	129	
Driller: A-1 DRUG SERV		Box 10631		. ,	
1	•	IS 39289-0631	L. S. Elevation:		
Date drilling completed: 9-13-01	, , ,	961-5210	P 1 #		
A-1 Arilling Deru	(601)334	4-6938 (fax)	E-log #:		
State Law requires that this rep	ort be prepared by the	driller in detail and filed w	vith the Department within		
30 days of completion of drilling			Turi dia Depui dineri widini		
Well Owner Informa		Wel	l Location		
Owner Name_ Roy NeesE		Lung	" Longitude 32 09 55"		
Owner Name	) <u>E</u> ,	Latitud 87 33 59	Langitudes	**	
Mailing Address: 1509 SCR #502		Method of Lat/Long (circle or	(0.1)		
		l - 1	,	ONG Paj	
TULASKI A	15 39152 ate Zip Code	5E 14 NW 14 Sec 26	Twn 4N Rng 7E	11/0	
Telephone No. ()		Distance Direction  2 Miles	Nearest Town of SURNS		
	Well I	Data			
Purpose of Well (circle one) Home (Industrial) Public Supply Irrigation Fish Culture Other:					
Date well drilling started: 9-08-	O4 Date	well drilling completed: _ 9-	13-04		
If flowing, method of flow regulation: Valve Other (describe)					
Static Water Level: 20 feet above or below (circle one) land surface Date measured: 9-13-04					
Method of Measurement (circle one) steel tape electric tape air line other:					
Hole depth: <u>B9'</u> Well depth: <u>B5'</u> Well grouted to a depth of <u>56</u> feet					
Type of grout (circle one): Cemen Bentonite Mix					
Casing length: 76 feet Casing diameter: 4 inches Type of casing: PVC					
Screen length: 10 feet Screen diameter: 4 inches Type of screen: PVC					
Screen slot size: <u>.006</u> inches Setting depth: From <u>75</u> feet to <u>85</u> feet					
Type of completion (circle all applicable): Gravel packed Underreamed Telescoped Open hole Chatural Development					
Other (describe):					
Top of lap pipe or reduction in casing:feet. If telescoped or more than one screen, describe on back of page					
Logs run (circle all applicable): No log run Electric Gamma Ray Density Sonic Neutron Other:					
Name of organization running log(s):					
I certify that the well was drilled, constructed, and completed in accordance with all applicable requirements of the Mississippi					
Department of Environmental Quality and/or the Mississippi Department of Health regulations and state laws					
A-IDRICHING SERV. INC 0410/10/ March Sun					
Print Name of Water Well Contractor and		7///	BECENED		

OCT 1 1 2004


BY: OLWR

If well telescopes please sketch below and show depths.

Ground Level B-3a	
	,

Description of Formations Encountered	From	То
Red clau	0	4
Tan clay	4	15
Tan & gray clay	1/5	42
Clark HANTO	42	63
Sould . V. for	63	84
Sand & Clay, Lignite	84	89
		<u> </u>

If more than one screen, show location of each on sketch

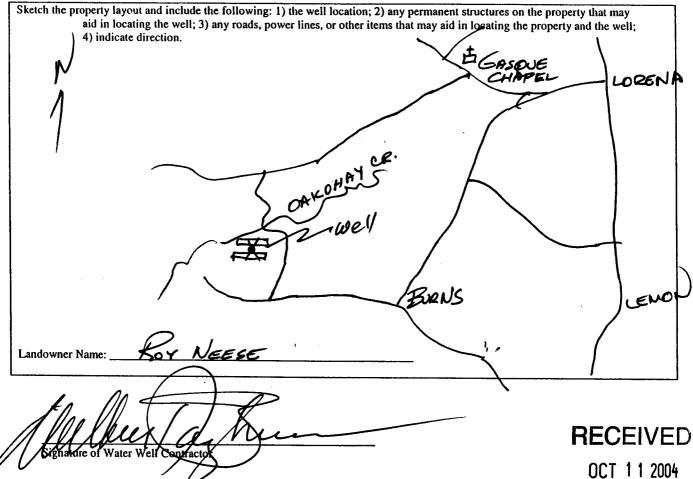

BY: OLWR

## STATE WELL REPORT

## Part 2

County: Permit #: Date completed: 9-13-04

**Pump Installer's Completion Report** Mississippi Department of Environmental Quality Office of Land and Water Resources P.O. Box 10631 Jackson, MS 39289-0631

(601)961-5210 (601)354-6938 (fax)

For Office Use Only:	
Aquifer:	
Well #: B-3a	
Elevation:	

This report should be prepared by the pump installer in deta installation of pump.	il and filed with the Department within 30 days of the	
Well Owner Information	Well Location	
Owner Name: Roy WEESE	Latitude: 89°33'59" Longitude: 32°09'59"	
Mailing Address:	Method of Lat/Long (circle one): Conventional Survey,	
1509 SCP# 502	USGS quad, Hand-held GPS, Survey-grade GPS	
City State Zip Code	SE 14 NW 14 Sec 25 Twn 4N Rng 7E	
· ·	Distance Direction Nearest Town	
Telephone No. ()	+Z Miles N of BURNS	
Pump Type	Power Type	
Circle one	Circle one	
Air Lift Jet Submersible	Diesel Engine Gasoline Engine Natural Gas	
Bucket Piston Turbine	Electric Motor Hand Tractor PTO	
Centrifugal Rotary Flowing Well	Windmill Other (specify):	
Other (specify):	Horse Power Rating of Motor:	
Date Pump Installed: 9-13-04	Setting Depth: 60 feet	
Rated Pump Capacity:	Number of Stages:	
Pump Test Data	Method of Measuring Water Level	
Date Well Tested:	Circle one	
Static Water Level (A):Feet Below Land Surface	Air Line Electric Measuring Line Steel Tape	
Pumping Water Level (B): Feet Below Land Surface	Other (specify):	
Drawdown [(B) - (A)]:  Feet Below Land Surface	For flowing well, measured shut in head:feet	
Test Pumping Rate:Gallons Per Minute	Well yielded NA GPM with a drawdown of	
Duration of Pump Test (minimum 4 hours): hours	feet afterhours of pumping	

I HEREBY CERTIFY that the above statements are true to the best of my knowledge.	,
MIKE EMUSHMAN 587 Willia Son	hem
Print Name of Pump Installer and License No. (if applicable)  Signature of Pump Install	

RECEIVED

OCT 11 2004

BY: OLWR