
, ·	- State W	ell Report	For Office Use Only:	
County: Scott Smith	Р	art 1		
County: <u>Sec 1</u> Well Permit #: <u>4</u> " Well	Mississippi Departmen	t of Environmental Quality	Aquifer:	
Permit #: 4 the	Office of Land a	nd Water Resources lox 10631	Well # 265-39	
Driller: Ar Nold Finchersr	Jackson, M	IS 39289-0631	L. S. Elevation:	
Date drilling completed: 10-12-04		961-5210 4-6938 (fax)	E-log #:	
Water well pervices	· · ·		ومحمد معوور معرفي منها والمعاجب معاجر ومعاجر ويواسك مجمع من المحمد والمحمد والمحمد والمحمد والمحمد والمحمد والم	
State Law requires that this re	port be prepared by the	driller in detail and filed v	with the Department within	
30 days of completion of drilling of the well. Well Owner Information		Well Location		
Owner Name Rita Hall			X" Longitude 089. 34 . 11 W	
Mailing Address: RTH Box 28 A		Method of Lat/Long (circle one): Conventional Survey,		
A		USGS quad, Hand-hel	d GPS Survey-grade GPS	
Pulaski, 1	Ms 39152 itate Zip Code	14 14 Sec 1	+ Twn 5N Rng 7E	
City 5 Telephone No. (60) 536-	•	Distance Direction Muarest Town, 8/2 Miles 5 of Pylaski		
	Wall	Dota		
			Chicken House	
Purpose of Well (circle one) Home	ndustrial Public Supply	Irrigation Fish Culture	Other: Critical The	
Date well drilling started: $10-5$	<u>-04</u> Date	well drilling completed: _/O	-10-07	
If flowing, method of flow regulation:	alve Other (describe)		
Static Water Level: 137 feet	above er below (circle one)	land surface Date measured	10-14-04	
Method of Measurement (circle one)				
Hole depth: <u>590</u> Well	1epth: 450	Weil grouted to a depth of	4 Dfeet	
Type of groat (circle one): Cement	Benionite Mix			
Casing length: 420 feet Cr	sing diameter:	inches Type of casing:	PUC	
50	creen diameter:	inches Type of screen:	PUC	
Screen slot size: 0.08 inche	s Setting depth: From			
Type of completion (circle all applicable	e): Gravel packed Unde	rreamed Telescoped Ope	n hole (Natural Development)	
	Other (describe):			
Top of lap pipe or reduction in casing:	feet. If t	elescoped or more than one so	reen, describe on back of page	
Logs run (circle all applicable): No log	run Electric Quamma Ra	Density Sonic Neutron	Other:	
	State Log	19105 Log	#0-0075	
Name of organization running log(s):	structed, and completed in			
Department of Environmental Quality	y and/or the Mississippi De	partment of Health regulation	ns and state laws.	
Arnold Finicher S.		and	Janeh 5	
Print Name of Water Well Contractor a		Signature	of Water Well Contractor	
Flint Mane of Water Holl Conductore			RECENTER	
			RECEIVED	

OCT 2 5 2004 BY: OLWR If well telescopes please sketch below and show depths.

<u>ج</u> ، ، ،

Ground Level B-3 2 0-24	Description of Formations Encountered	From	То
	Surfact Sande Clay	0	40
	Sand	40	75
	Yazzo clay	75	385
	1 Squd	385	395
	Clay	395	415
	Sand	415	560
	Clay	460	590
	·		
			I
			
			L

If more than one screen, show location of each on sketch

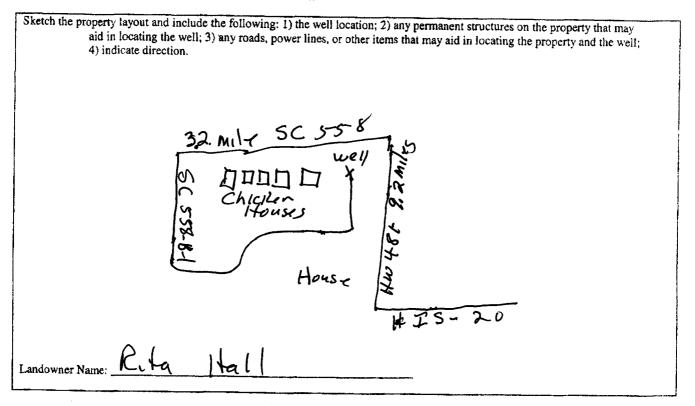

0598

Signature of Water Well Contractor

RECEIVED OCT 2 5 2004 BY: OLWR

STATE WELL REPORT						
County: Karadia Scot Permit #: 4" Weall Driller: Avan & Finicher S Date completed: 10-15-04 This report should be prepared 1	Pump Installer's Mississippi Departmen Office of Land a P.O. I Jackson, M (601) (601)35	art 2 s Completion Report it of Environmental Quality and Water Resources Box 10631 1S 39289-0631 961-5210 4-6938 (fax) il and filed with the Department	For Office Use Only: Aquifer: Well #: D-26B-34 Elevation: Int within 30 days of the			
installation of pump. Well Owner Info	rmation	Well Location				
Owner Name: <u>Rita</u> Ha Mailing Address: <u>RT#1</u>	<u>all</u>	Latitude: $321228 \mathcal{N}$ Longitude: $0893411 \mathcal{W}$ Method of Lat/Long (circle one): Conventional Survey,				
Mailing Address: /- / -//						
Pulaski, 1. City 536 -	<u>Ms 39152</u> Tate Zip Code	USGS quad, $\underbrace{\text{Hand-held GPS}}_{4}$ Survey-grade GPS $\underline{4}_{4}$ Sec $\underline{34}_{4}$ Twn $\underline{5N}_{4}$ Rng $\underline{7E}_{4}$ Distance Direction Nearest Town Miles of				
		WinesC	л			
Pump Typ Circle one		Power Type Circle one				
Air Lift Jet	Submersible	Diesel Engine Gasoli	ne Engine Natural Gas			
Bucket Piston	Turbine	Electric Motor Hand	Tractor PTO			
Centrifugal Rotary	Flowing Well	Windmill Other	(specify):			
Other (specify):		Horse Power Rating of Motor	5			
Date Pump Installed: 10 - 19	<u> -04</u>	Setting Depth: 22	0feet			
Rated Pump Capacity:	Gallons Per Minute	Number of Stages:	5			
Pump Test I		Method of Measuring Water Level Circle one				
Date Well Tested: Static Water Level (A): 137	Feet Below Land Surface	Air Line Electric Me	asuring Line Steel Tape			
3 M C	Feet Below Land Surface	Other (specify):	······			
67	_Feet Below Land Surface	For flowing well, measured s	hut in head:feet			
6-7	Gallons Per Minute	Well yielded GPM with a drawdown of				
Duration of Pump Test (minimum 4 h	ours): <u>6</u> hours	feet after _	hours of pumping			
I HEREBY CERTIFY that the above statements are true to the best of my knowledge. Annold Fincher St 0598 Print Name of Pump Installer and License No. (if applicable) Signature of Pump Installer RECEIVED						

ć' "

0CT 2 5 2004 BY: OLWR

.