

SMITH
B 2000
6-25-77

MISSISSIPPI
BOARD OF WATER COMMISSIONERS
416 North State Street
Jackson, Mississippi 39201

WATER WELL DRILLERS LOG

6-25 1977 Adcock water well Ser. Smith
date well completed firm name county well located

LANDOWNER: S. L. Stewart
Rt 1 Pulaski
(mailing address)

WELL LOCATION:
sec. 29 T. 4 N R. 7 E
S W
App. 6 miles East of Poikville
(distance) (direction) (nearest town)

WELL PURPOSE: Home Use
(home, irrigation, municipal, industrial)

- WELL COMPLETION DATA:
- (1) diameter (inches) 2"
 - (2) total depth (feet) 671
 - (3) static water level (feet) 180 below above top of ground.
 - (4) casing glass, 656, (material) (depth)
 - (size) if telescope see back.
 - (5) screen 15 feet, 671 to 656 (length) (depth to top)
2", Stainless (size) (material)
 - (6) pump 2", 25 per min. (HP) (yield gpm)
Electric (type power)
 - (7) electric log No (yes or no)
 - (organization running log)
 - (8) how well bottom plugged Broken seal


description of formations encountered	from	to
Clay	0	63
Clay + sand	63	126
Clay	126	192
Rock + shell	192	194
Clay	194	399
Rock + shell + sand	399	420
Rock + shell + sand	420	462
Clay	462	483
Clay + sand	483	525
Clay + sand	525	546
sand	546	560
rock	560	562
clay	562	600
sand + clay	600	630
sand	630	671

RECEIVED
JUL 13 1977
MISS. Bd. OF WATER COMM.

DRILLERS REMARKS:

If well telescopes please sketch and show depths.

GROUND LEVEL

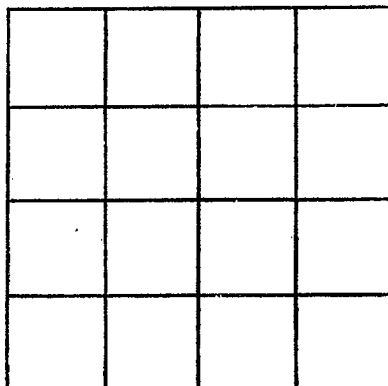

SECTION _____

Please indicate well location X.

ADDITIONAL INFORMATION

If more than one screen, show locations of each on sketch.