

SMITH

MISSISSIPPI
BOARD OF WATER COMMISSIONERS
416 North State Street
Jackson, Mississippi 39201

WATER WELL DRILLERS LOG

?
B 2002
8/1/80
Aug 1

1980 Roy U West Drly Smith
date well completed firm name county well located

LANDOWNER:	description of formations encountered	from	to
RALIEGH FOREST PROD.	CLAY	0	3
RALIEGH MS (mailing address)	SAND	2 3	112 112
WELL LOCATION:			
sec. <u>25</u> T <u>4</u> N R <u>7</u> E S W			
<u>8</u> miles <u>N</u> of <u>RALIEGH</u> (distance) (direction) (nearest town)			
WELL PURPOSE: <u>Industrial</u> (home, irrigation, municipal, industrial)			
WELL COMPLETION DATA:			
(1) diameter (inches) <u>4"</u>			
(2) total depth (feet) <u>112'</u>			
(3) static water level (feet) <u>90'</u> below top of ground. above			
(4) casing <u>PVC</u> , <u>102'</u> (material) (depth)			
<u> </u> (size) if telescope see back.			
(5) screen <u>10'</u> , <u>102'</u> (length) (depth to top)			
<u>4"</u> , <u>PVC</u> (size) (material)			
(6) pump <u>1/2</u> , <u>7</u> (HP) (yield gpm)			
<u>REA</u> (type power)			
(7) electric log <u>NO</u> (yes or no)			
<u> </u> (organization running log)			
(8) how well bottom plugged <u>WASH VALVE</u>			
DRILLERS REMARKS:			


DEPT. OF NATURAL RESOURCES
BUREAU OF LAND & WATER RESOURCES

AUG 8 1980

RECEIVED

If well telescopes please sketch and show depths.

GROUND LEVEL

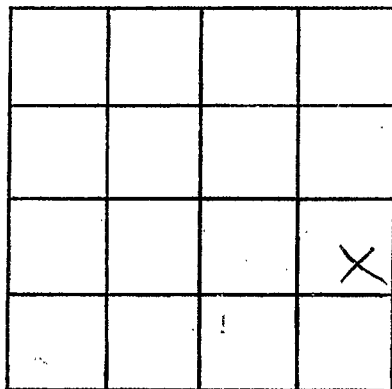

SECTION _____

Please indicate well location X.

ADDITIONAL INFORMATION

If more than one screen,
show locations of each on sketch.