

Smith  
B2003

MISSISSIPPI  
 BOARD OF WATER COMMISSIONERS  
 416 North State Street  
 Jackson, Mississippi 39201

WATER WELL DRILLERS LOG


Aug 6 1984 Roy West Dalg Smith  
 date well completed firm name county well located

LANDOWNER:	description of formations encountered	from	to
<u>Jimmy Parkman</u> <u>Pulaski MS</u> (mailing address)			
	<u>SAND CLAY STRKS</u>	<u>2</u>	<u>10</u>
	<u>SAND</u>	<u>10</u>	<u>17</u>
	<u>CLAY</u>	<u>17</u>	<u>69</u>
	<u>SAND</u>	<u>69</u>	<u>78</u>
	<u>CLAY</u>	<u>78</u>	<u>79</u>
	<u>SAND</u>	<u>79</u>	<u>89</u>
WELL LOCATION: sec. <u>35</u> <u>4</u> <u>N</u> R. <u>7</u> <u>E</u> <u>10</u> miles <u>N</u> of <u>RALEIGH</u> (distance) (direction) (nearest town)			
WELL PURPOSE: <u>Chicken house</u> (home, irrigation, municipal, industrial)			
WELL COMPLETION DATA:			
(1) diameter (inches) <u>2"</u>			
(2) total depth (feet) <u>89'</u>			
(3) static water level (feet) <u>40'</u> below top of ground.			
(4) casing <u>PVC</u> <u>84'</u> (material) (depth)			
<u>2"</u> (size) if telescope see back.			
(5) screen <u>5'</u> <u>84'</u> (length) (depth to top)			
<u>2"</u> <u>PVC</u> (size) (material)			
(6) pump <u>1</u> <u>12</u> (HP) (yield gpm)			
<u>REA</u> (type power)			
(7) electric log <u>NO</u> (yes or no)			
(organization running log)			
(8) how well bottom plugged <u>was not plugged</u>			
DRILLERS REMARKS:			

DEPT. OF NATURAL RESOURCES  
 BUREAU OF LAND & WATER RESOURCES  
 AUG 8 1984  
 RECEIVED

If well telescopes please sketch and show depths.

GROUND LEVEL

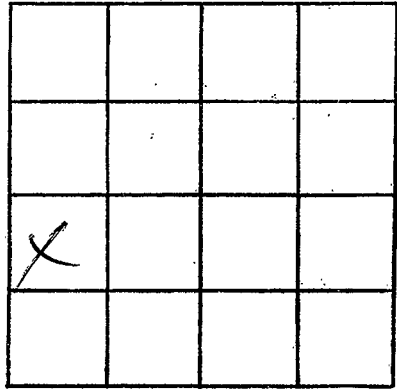

SECTION 35

Please indicate well location X.

ADDITIONAL INFORMATION

If more than one screen,  
show locations of each on sketch.