

MISSISSIPPI DEPARTMENT OF NATURAL RESOURCES

Bureau of Land and Water Resources

COUNTY WELL LOCATED Smith	
WELL NUMBER B 2005	CODED
DATE WELL COMPLETED 4-19-88	

PERMIT NUMBER
NAME OF DRILLING FIRM Roy U. West

P.O. Box 10631
Jackson, Mississippi 39209
WATER WELL DRILLERS LOG

NAME & MAILING ADDRESS OF LANDOWNER John Russom		
Rt 1 Box 54		
Pulaski MS 39152		
WELL LOCATION: SEC	TOWNSHIP	RANGE
26	4	N 7 E
DISTANCE	DIRECTION	NEAREST TOWN
8 Miles	N	of Raleigh
OTHER LANDMARK		
WELL PURPOSE: <input checked="" type="checkbox"/> Home, <input type="checkbox"/> Irrigation, <input type="checkbox"/> Municipal, <input type="checkbox"/> Industrial, <input type="checkbox"/> Fish Pond, etc.		

PUMP DATA		
PUMP TYPE (Circle One): <input checked="" type="checkbox"/> Submersible, <input type="checkbox"/> Turbine, <input type="checkbox"/> Jet, <input type="checkbox"/> Flowing Well, Other (Describe) _____		
POWER TYPE (Circle One): <input checked="" type="checkbox"/> Electric, <input type="checkbox"/> Tractor, <input type="checkbox"/> Diesel, <input type="checkbox"/> Gasoline, <input type="checkbox"/> Butane, Other (Describe) _____		
Pump Capacity (GPM)	No. of Stages	Setting Depth
5	12	120' FT.
PUMP TEST		
Well yielded 8 GPM with a drawdown of 30' ft. after 1 hours of pumping		

WELL DATA		
Well Depth 135'	Casing Diameter (In.) 4"	Casing Length (Ft.) 125'
Type of Casing PVC	Hole Depth 135'	Depth to Static Water Level 60'
TYPE OF COMPLETION: (Circle One or More): <input checked="" type="checkbox"/> Gravel Packed, <input type="checkbox"/> Underreamed, <input type="checkbox"/> Telescoped, <input checked="" type="checkbox"/> Natural Development, <input type="checkbox"/> Open Hole, <input type="checkbox"/> Other (Describe) _____		
Top of Lap Pipe or Reduction in Casing FEET IF TELESCOPED OR MORE THAN ONE SCREEN: USE BACK PAGE		

LOG DATA	
TYPE OF LOG RUN (Circle One): <input checked="" type="checkbox"/> Electric, <input type="checkbox"/> Gamma Ray, <input type="checkbox"/> Density, <input type="checkbox"/> Sonic, <input type="checkbox"/> Neutron, Other (Describe) _____	
Name of Organization Running Log	

SCREEN DATA		
Diameter - Inches 4"	Length - Feet 10'	Slot Size - Inches .010
Screen Type PVC SAW SLOT	Depth to Bottom - Feet 135'	

GEOLOGIC DATA (Office Use Only)			
Surface Elev.	Geologic Unit	Unit Thickness	Depth to Top
Subs. SWL	Date	Analysis	Aquifer Test

Driller's Remarks

DESCRIPTION OF FORMATIONS ENCOUNTERED	FROM	TO
CLAY	0	16
SAND	16	23
CLAY	23	38
SAND	38	50
CLAY	50	127
SAND	127	135


RECEIVED

<div style="font-size: 1.5em; font-weight: bold;">RECEIVED</div> <p style="font-size: 1.2em; font-weight: bold;">JUN 07 1988</p> <p style="font-weight: bold;">Department of Natural Resources Bureau of Land & Water Resources</p>	<table border="1" style="width: 100%; border-collapse: collapse;"> <thead> <tr> <th>FORMATIONS (Continued)</th> <th>FROM</th> <th>TO</th> </tr> </thead> <tbody> <tr> <td> </td> <td> </td> <td> </td> </tr> <tr> <td> </td> <td> </td> <td> </td> </tr> <tr> <td> </td> <td> </td> <td> </td> </tr> <tr> <td> </td> <td> </td> <td> </td> </tr> </tbody> </table>	FORMATIONS (Continued)	FROM	TO												
FORMATIONS (Continued)	FROM	TO														

IF MORE SPACE IS NEEDED, USE BACK

If well telescopes please
sketch and show depths.

GROUND LEVEL

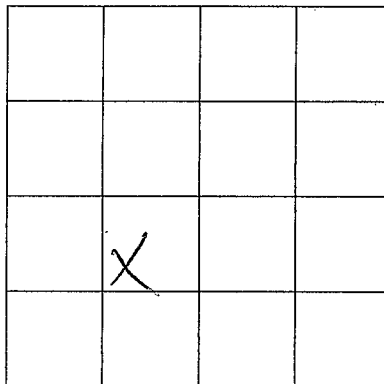

SECTION 26

Please indicate well location X.

ADDITIONAL INFORMATION

If more than one screen,
show location of each on sketch.