

SMITH

MISSISSIPPI BOARD OF WATER COMMISSIONERS

5 C-2  
5-9-61

WATER WELL DRILLERS LOG

0 7  
96-1  
95-2

Date: 5/9, 1961, Driller: James McGee County Smith  
(Name)

(1) Owner of Land: Mrs. Glorinda Phipps  
This well located <sup>(Name)</sup> about 14 miles  
South of Forest on Hwy. 35. Across

Hwy. in front of <sup>(Address)</sup> Lorena B. Church.

(2) Location: 1/4, 1/4, Sec. 17 T. 11 R. 8E  
14 miles South, of Forest.  
(distance) (direction) (Nearest Town)

(3) Topography: x (Hilly) (Flat) (Level)

(4) Purpose of Well: Domestic  
(Domestic Irrigation  
Municipal, Industrial, Other)

Description & Color of Materials Sand, Clay, Red Clay, Shell, etc.	Thick- ness Feet	Depth Feet
Clay.		0-42
Clay & stks. mucky sand.		42-62
Fine sand & stks. clay.		62-82
Fine sand.		82-98
Clay & stks. sand.		98-101
Fine sand.		101-122
Clay & stks. fine sand.		122-142
Clay & stks. rock.		142-162
Clay.		162-312
Shale.		312-402
Shale & stks. rock.		402-432
Shale.		432-495
Clay & mucky sand.		495-525
Fine sand & stks. coal.		525-545
Fine sand.		545-550
Clay.		550-555
Sand. (Screen setting)		555-580

Information upon completion of well:

(1) Diameter 2 inches.

(2) Total Depth 580 feet.

(3) Water Level 170 feet below top of ground.

(4) Cased to 560', Size 2"

(5) Screen: Size 2", Length 20'


(6) Were any formations sealed against pollution?  
yes, x no.

If YES depth of formation \_\_\_\_\_

Why \_\_\_\_\_

Drillers Remarks: Good well.

Hard.  
Fe Stain  
Air Comp  
3 hp

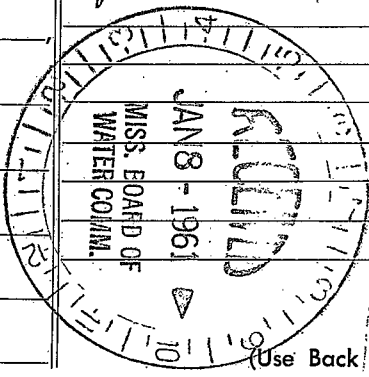

Well No.

