

0

Smith
3 C5
3-67

MISSISSIPPI
BOARD OF WATER COMMISSIONERS
416 North State Street
Jackson, Mississippi 39201

WATER WELL DRILLERS LOG

Mar 31 1967 W.H. Butler Smith
date well completed firm name county well located

LANDOWNER:

H.G. Berryhill
Rt 2, Forest, Miss
(mailing address)

description of formations
encountered

from to

| | | |
|------------------|-----|-----|
| Red Clay + Sand | 1 | 10 |
| Sand + Chalk | 10 | 20 |
| Chalk | 20 | 30 |
| Sand + Chalk | 30 | 50 |
| Chalk | 50 | 90 |
| Sand + Chalk | 90 | 105 |
| Sand | 105 | 110 |
| Sand + Limestone | 110 | 120 |
| Chalk + Sand | 120 | 145 |
| Sand | 145 | 150 |
| Sand + Chalk | 150 | 160 |
| Sand | 160 | 176 |
| Chalk + Sand | 176 | 180 |

WELL LOCATION:


sec. 32 T 4 N R 8 E
S W
1.0 miles N of Raleigh
(distance) (direction) (nearest town)

WELL PURPOSE:

HOME
(home, irrigation, municipal, industrial)

WELL COMPLETION DATA:

- (1) diameter (inches) 2"
- (2) total depth (feet) 180'
- (3) static water level (feet) 90' below top of ground.
- (4) casing galv. 165'
(material) (depth)
- 3" if telescope see back.
(size)
- (5) screen 5' 168'
(length) (depth to top)
- 2" S. Steel
(size) (material)
- (6) pump 1 (HP) 5- (yield gpm)
- Electric
(type power)
- (7) electric log No
(yes or no)

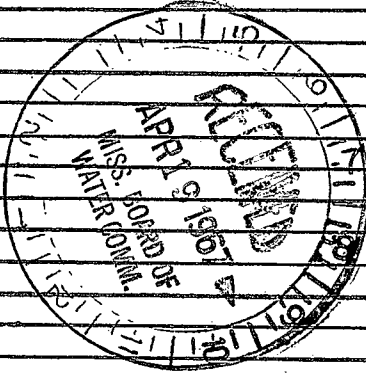

(organization running log)


(8) how well bottom plugged 2" Back Wash Valve

DRILLERS REMARKS:

If well telescopes please sketch and show depths.

GROUND LEVEL

NE, SW

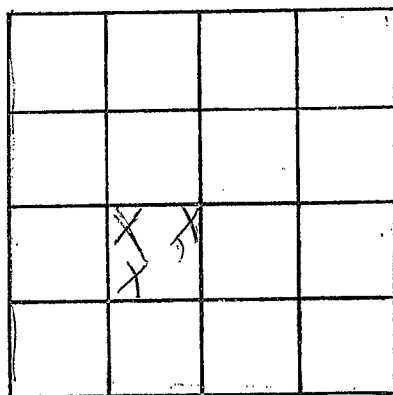

SECTION 32

Please indicate well location X.

ADDITIONAL INFORMATION

If more than one screen, show locations of each on sketch.