

SMITH

MISSISSIPPI BOARD OF WATER COMMISSIONERS

5 C6


7-28-65

WATER WELL DRILLERS LOG

Smith

Date: 7/28, 1965, Driller: Forest Drilling County Scott
(Name)

	Description & Color of Materials Sand, Clay, Red Clay, Shell, etc.	Thick- ness Feet	Depth Feet
(1) Owner of Land: <u>W. N. Currie</u> (Name) <u>Rt 2 Foush Miss</u> (Address) <u>408 SE</u>	Clay	0	12
(2) Location: <u>1/4</u> , <u>1/4</u> , Sec. <u>17</u> T. <u></u> R. <u></u> <u>2</u> miles <u>North</u> of <u>Lemon</u> (distance) (direction) (Nearest Town)	Clay + Shale Clay Clay + Shale Clay + Shale	112	22 112 132 132 192
(3) Topography: <u></u> (Hilly) (Flat) (Level)	Clay		311
(4) Purpose of Well: <u>Home</u> (Domestic Irrigation Municipal, Industrial, Other)	Shale		406
Information upon completion of well:	Shale + Shale Rock		416
(1) Diameter <u>2</u> inches.	Shale		436
(2) Total Depth <u>637</u> feet.	Shale + Rock		446
(3) Water Level <u>190</u> feet below top of ground.	Shale		456
(4) Cased to <u>622</u> , Size <u>2"</u>	Shale + Rock		476
(5) Screen: Size <u>2"</u> , Length <u>157</u> ft.	Shale + Shale Rock		486
(6) Were any formations sealed against pollution? <u>yes</u> , <u>no</u> .	Shale + Shale Rock		526
If YES depth of formation _____	Fine Sand + Clay		536
Why _____	Shale + Shale Rock		556
Drillers Remarks: _____	Fine Sand + Clay		616
	Fine Sand		637

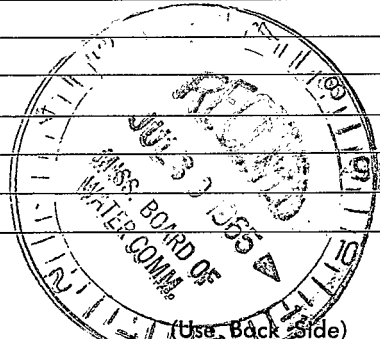

Well No.

