

SMITH

MISSISSIPPI BOARD OF WATER COMMISSIONERS

S C B

4-14-66

WATER WELL DRILLERS LOG

Date: 4/14, 1966, Driller: Forest Dilling County Smith (Name)

(1) Owner of Land: Wlyne Currie
 (Name)
Rt 2 Forest, Miss
 (Address)

(2) Location: 1/4, 1/4, Sec. 6 4N 5E
 (distance) (direction) (Nearest Town)

(3) Topography: Flat
 (Hilly) (Flat) (Level)

(4) Purpose of Well: Hen farm
 (Domestic Irrigation
 Municipal, Industrial, Other)

Description & Color of Materials Sand, Clay, Red Clay, Shell, etc.	Thick- ness Feet	Depth Feet
Red Clay		12
Red sand, clay		22
Blue clay		42
Clay		72
Clay + grey sand		82
Fine sand clay		102
Fine sand		112
Clay + grey sand		122
Fine sand + sths clay		142
Fine sand		152
Clay		159
Fine sand		172
Clay + sths fine sand		192
Fine sand		202
Fine sand		212

Information upon completion of well:

(1) Diameter 2 inches.

(2) Total Depth 212 feet.

(3) Water Level 100 feet below top of ground.

(4) Cased to 202, Size 2".


(5) Screen: Size 2", Length 10 ft.

(6) Were any formations sealed against pollution?
 yes, no.

If YES depth of formation _____

Why _____

Drillers Remarks: _____

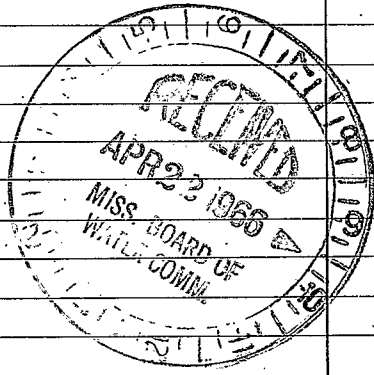

(Use Back Side)

Well No.

