

Smith
6
7-66
C10

MISSISSIPPI BOARD OF WATER COMMISSIONERS

WATER WELL DRILLERS LOG

Date: July 19, 1966, Driller: W. G. Butler County SMITH
(When well drilled) (Name) (Where well is located)


(1) Owner of Land: CLIFTON BRUCE
(Name)
Raleigh, MISS.
(Address)
 (2) Location: SW 1/4, SW 1/4, Sec. 32 T8 R2
6 miles NE of Raleigh
(distance) (direction) (Nearest Town)
 (3) Topography: (Hilly) (Flat) (Level)
 (4) Purpose of Well: Domestic
(Domestic Irrigation, Municipal, Industrial, Other)

Description & Color of Materials Sand, Clay, Red Clay, Shell, etc.	Thick- ness. Feet	Depth Feet
Red Clay	1-	10
Rock + Chalk	10-	18
Shell + Sand	18-	20
Rock Chalk + Shell	20-	25
Sand, Chalk + Shell	25-	30
Lignite, Chalk + Shell	30-	40
Chalk	40-	50
Chalk + Sand	50-	60
Lignite + Chalk	60-	70
Chalk	70-	90
Chalk + Shell	90-	97
Sand -	97-	110

Information upon completion of well:

(1) Diameter 2 inches.
 (2) Total Depth 110 feet.
 (3) Water Level 50 feet below top of ground.
 (4) Cased to 100, Size 2"
 (5) Screen: Size 2", Length 5"
 (6) Were any formations sealed against pollution?
 yes, no.

If YES depth of formation _____
 Why _____
 Drillers Remarks: _____
 Yield in gpm: 6 gal
 Size pump: 3/4
 Type power: Elec

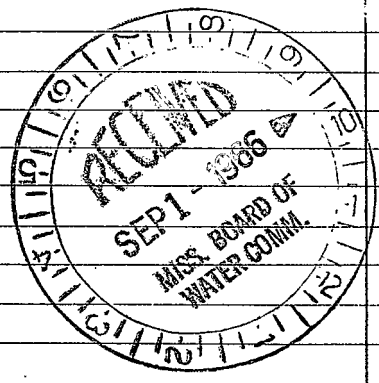

Retain this copy for your office files.

