

E-109 #162

Coded

MISSISSIPPI
BOARD OF WATER COMMISSIONERS
416 North State Street
Jackson, Mississippi 39201

CODED

WATER WELL DRILLERS LOG

SMITH
C 13
1-31-70
MGS

1-31 date well completed 1970 CONRAD Drilling service firm name SMITH county well located

LANDOWNER: Randall Young

description of formations encountered from to

Pulaski R#1
Miss
(mailing address)

Clay 0 180

WELL LOCATION:
sec. 6 T. 44 N. R. 8 E. S. 5 W.
13 miles SOUTH of Forest
(distance) (direction) (nearest town)

Sandy clay 180 210

Clay 210 460

WELL PURPOSE: Home
(home, irrigation, municipal, industrial)

Sandy clay 460 600

WELL COMPLETION DATA:

layers 600 643

(1) diameter (inches) 2"
(2) total depth (feet) 643
(3) static water level (feet) 135 below above top of ground.
(4) casing Steel (material) (depth)

Sandy clay 643 718

(size) if telescope see back.

(5) screen 10 (length) 635 (depth to top)
2" (size) Stanley steel (material)

(6) pump AIR COMPRESSOR (HP) (yield gpm)
5 HP (type power) Compressor Electric

(7) electric log Yes (yes or no)
State (organization running log)

(8) how well bottom plugged Valve

DRILLERS REMARKS:


FEB 16 1970

MISS. BD. OF
WATER COMMISSIONERS

CODED

If well telescopes please sketch and show depths.

GROUND LEVEL

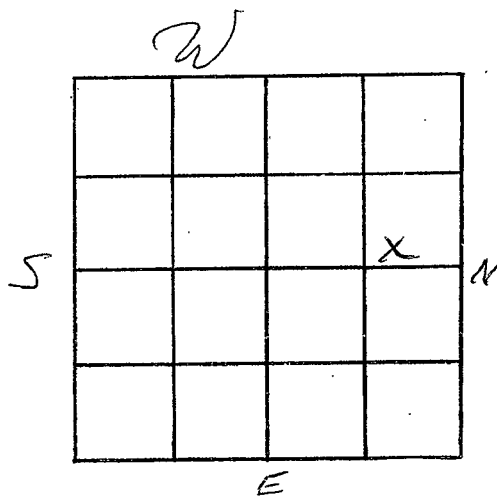

SECTION 2

Please indicate well location X.

ADDITIONAL INFORMATION

If more than one screen, show locations of each on sketch.