

MISSISSIPPI
BOARD OF WATER COMMISSIONER
416 North State Street
Jackson, Mississippi 39201

CODED

WATER WELL DRILLERS LOG

Smith
C 16
6-69

June 1969 Wilkinson Drilling Smith
date well completed firm name county well located
Lake

LANDOWNER:

Mr Sam Goodson
Forest MISS
(mailing address)

description of formations encountered

from to

<u>yellow clay</u>	<u>0</u>	<u>30</u>
<u>blue sil</u>	<u>30</u>	<u>175</u>
<u>Rock + SAND</u>	<u>175</u>	<u>180</u>
<u>blue clay</u>	<u>180</u>	<u>290</u>
<u>blue sil</u>	<u>290</u>	<u>380</u>
<u>blue shale</u>	<u>380</u>	<u>390</u>
<u>SAND</u>	<u>390</u>	<u>425</u>

WELL LOCATION:

sec. 1 T. 4 N. R. 8 E.
12 miles S of Forest
(distance) (direction) (nearest town)

WELL PURPOSE:

home
(home, irrigation, municipal, industrial)

WELL COMPLETION DATA:

- (1) diameter (inches) 2
- (2) total depth (feet) 424
- (3) static water level (feet) 60 below top of ground.
- (4) casing Galv, 420,
(material) (depth)
- 2 If telescope see back.
(size)
- (5) screen 4, 424
(length) (depth to top)
- 2, Stainless
(size) (material)
- (6) pump 1, 9
(HP) (yield gpm)
- elec
(type power)
- (7) electric log NO
(yes or no)

(organization running log)

- (8) how well bottom plugged 2 B.W.U.

DRILLERS REMARKS:


CODED

JUN 30 1969

MISS. BD. OF
WATER COMM.

If well telescopes please sketch and show depths.

GROUND LEVEL

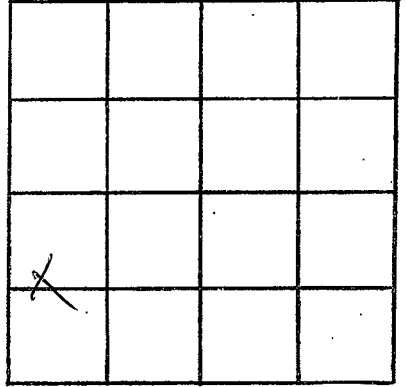

SECTION 1

Please indicate well location X.

ADDITIONAL INFORMATION

If more than one screen,
show locations of each on sketch.