

MISSISSIPPI DEPARTMENT OF NATURAL RESOURCES

Bureau of Land and Water Resources

Southport Mall

P.O. Box 10631

Jackson, Mississippi 39209

WATER WELL DRILLERS LOG

Smith
C 19

CODED

10-22-85

Griner Drilling Service, Inc.

Smith

date well completed

firm name

county well located

LANDOWNER:

Union Explorations Partners
P.O. Box 7096
Houma, LA. 70361
(mailing address)

description of formations encountered

from

to

CLAY, SAND

0 21

Blue gumbo

21 250

WELL LOCATION:

661' N + 654' E

sec. 26 T. 4 N. R. 8 E of SW/4

CLAY, SAND, shell streaked

250 460

North Raleigh
A town (distance) miles (direction) of (nearest town)

SAND

460 520

WELL PURPOSE: oilfield supply
(home, irrigation, municipal, industrial)

CLAY

520 525

WELL COMPLETION DATA:

(1) diameter (inches) 3"

(2) total depth (feet) 525'

(3) static water level (feet) 10' below above top of ground.

(4) casing steel 525' (material) (depth)

CODED

3" (size) if telescope see back.

(5) screen 42' 483' (length) (depth to top)

3" perforated (size) (material)

(6) pump - 75-80 (HP) (yield gpm)

AC (type power)

(7) electric log (yes or no)

(organization running log)

(8) how well bottom plugged orange peel


RECEIVED
DEC 16 1985

DRILLERS REMARKS:

Department of Natural Resources
Bureau of Land & Water Resources

If well telescopes please sketch and show depths.

GROUND LEVEL

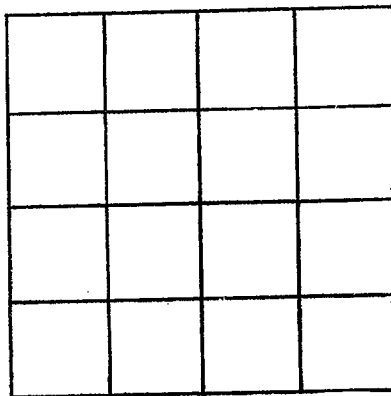

SECTION _____

Please indicate well location X.

ADDITIONAL INFORMATION

If more than one screen, show locations of each on sketch.