

MISSISSIPPI DEPARTMENT OF NATURAL RESOURCES

Bureau of Land and Water Resources

Southport Mall

P.O. Box 10631

Jackson, Mississippi 39209

WATER WELL DRILLERS LOG

CODED

Smith
C 20
8-12-86

Griner Drilling Service, Inc.

Smith

8-12-86 date well completed

Griner Drilling Service, Inc. firm name

Smith county well located

| LANDOWNER: | description of formations encountered | from | to |
|--|---------------------------------------|------|-----|
| Chesley Pruett Drilling P.O. Box 324 Laurel, Ms. 39440 (mailing address) | sand, clay | 0 | 20 |
| | clay | 20 | 545 |
| WELL LOCATION: 524' N x 590' W sec. 20 T. 4 N R. 8 E of No. 1 A. 20-16 S Lorena U.S.A. miles (distance) of (direction) (nearest town) | sand | 545 | 602 |
| | clay | 602 | 612 |
| WELL PURPOSE: oilfield supply (home, irrigation, municipal, industrial) | | | |
| WELL COMPLETION DATA: | | | |
| (1) diameter (inches) 3" | 65 | | |
| (2) total depth (feet) 612' | 65 | | |
| (3) static water level (feet) 80' below top of ground. | 130 | | |
| (4) casing steel 610' (material) (depth) 3" (size) if telescope see back. | | | |
| (5) screen 63' 547' (length) (depth to top) 3" perforated (size) (material) | | | |
| (6) pump - 70-75 (HP) (yield gpm) AC (type power) | | | |
| (7) electric log (yes or no) | | | |
| (organization running log) | | | |
| (8) how well bottom plugged orange peel | | | |

CODED

RECEIVED


OCT 16 1986

Department of Natural Resources
Bureau of Land & Water Resources

DRILLERS REMARKS:

If well telescopes please
sketch and show depths.

GROUND LEVEL

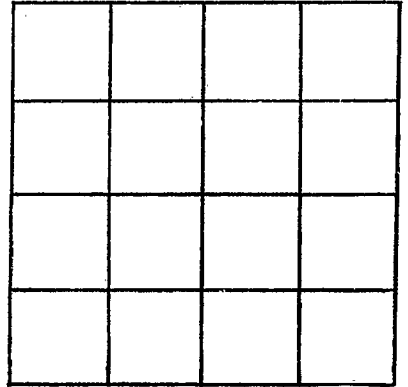

SECTION _____

Please indicate well location X.

ADDITIONAL INFORMATION

If more than one screen,
show locations of each on sketch.