

MISSISSIPPI DEPARTMENT OF NATURAL RESOURCES

Bureau of Land and Water Resources

Southport Mall

P.O. Box 10631

CODED

Jackson, Mississippi 39209

WATER WELL DRILLERS LOG

Smith
C 21

252A

Griner Drilling Service, Inc.

Smith

4-17-90 date well completed

firm name

county well located

LANDOWNER:

Chesley Pruet Drilling Co

P.O. Box 447
Laurel, MS. 39441
(mailing address)

description of formations encountered

gumbo clay

from

to

0 378

Good sand

378 420

WELL LOCATION: 2020' W 2140' E

sec. 16 T 4 N R 8 E of
Maynard oil CO. Lorena NW/400.

(distance, miles) (direction) or (nearest town)

WELL PURPOSE: oilfield rig supply
No. of production (home, irrigation, municipal, industrial)

WELL COMPLETION DATA:

(1) diameter (inches) 3"

(2) total depth (feet) 470

(3) static water level (feet) 85' below top of ground.

(4) casing PVC 390 (material) (depth)

3" (size) if telescopic pipe back 390' 420'

(5) screen 30' (length) 300 (depth to top)

3" (size) PVC slotted (material)

(6) pump (HP) 70 (yield gpm)

AC (type power)

(7) electric log (yes or no)

(organization running log)

(8) how well bottom plugged 3" plug

DRILLERS REMARKS:


RECEIVED

JUN 18 1990

Department of Natural Resources
Bureau of Land & Water Resources

If well telescopes please
sketch and show depths.

GROUND LEVEL

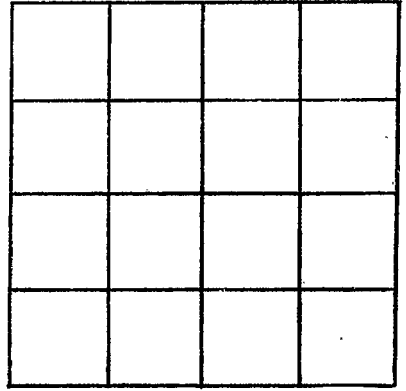

SECTION _____

Please indicate well location X.

ADDITIONAL INFORMATION

If more than one screen,
show locations of each on sketch.