

MISSISSIPPI DEPARTMENT OF NATURAL RESOURCES
Bureau of Land and Water Resources
 Southport Mall
 P.O. Box 10631
 Jackson, Mississippi 39209
WATER WELL DRILLERS LOG

SMITH
C 2000

July 24 1986 Thomas Sons Smith
 date well completed firm name county well located

LANDOWNER: Bill Carrie
Route 2
Forest, MS
 (mailing address)

| description of formations encountered | from | to |
|---------------------------------------|-----------|------------|
| <u>Chalk + Sand</u> | <u>0</u> | <u>20</u> |
| <u>Gray Chalk</u> | <u>20</u> | <u>30</u> |
| <u>Course Sand</u> | <u>30</u> | <u>105</u> |

WELL LOCATION:
 sec. 20 T 4 N R 9 E
2 miles S of Lorena
 (distance) (direction) (nearest town)

WELL PURPOSE: Home
 (home, irrigation, municipal, industrial)

- WELL COMPLETION DATA:
- (1) diameter (inches) 2"
 - (2) total depth (feet) 105'
 - (3) static water level (feet) 35' ^{below} above top of ground.
 - (4) casing PVC, 105'
 (material) (depth)
2" if telescope see back.
 (size)
 - (5) screen 10' 95'
 (length) (depth to top)
2" PVC
 (size) (material)
 - (6) pump Air Capp. 15
 (HP) (yield gpm)
220
 (type power)
 - (7) electric log —
 (yes or no)
—
 (organization running log)
 - (8) how well bottom plugged Seal

DRILLERS REMARKS:


RECEIVED

DEC 19 1986

Department of Natural Resources
 Bureau of Land & Water Resources

If well telescopes please
sketch and show depths.

GROUND LEVEL

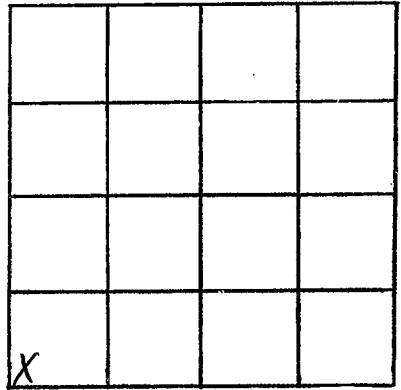

SECTION 20

Please indicate well location X.

ADDITIONAL INFORMATION

If more than one screen,
show locations of each on sketch.