

**MISSISSIPPI DEPARTMENT OF NATURAL RESOURCES**  
**Bureau of Land and Water Resources**  
 Southport Mall  
 P.O. Box 10631  
 Jackson, Mississippi 39209  
**WATER WELL DRILLERS LOG**

SMITH  
C2003

August 21, 1986 Thompson Smith  
 date well completed firm name county well located

**LANDOWNER:** Edward Tullis  
Rt. 2 Box 155 (Lorena)  
Forest, MS  
 (mailing address)

description of formations encountered	from	to
<u>Brown Dirt</u>	<u>0</u>	<u>20</u>
<u>Gray Chalk</u>	<u>20</u>	<u>40</u>
<u>Black Dirt</u>	<u>40</u>	<u>80</u>
<u>Five Gray Sand</u>	<u>80</u>	<u>90</u>
<u>Sand &amp; chalk mixed</u>	<u>90</u>	<u>120</u>
<u>White Sand</u>	<u>120</u>	<u>150</u>

**WELL LOCATION:**  
 sec. 19 T. 4 (N) R. 3 (E)  
2 miles S of Lorena  
 (distance) (direction) (nearest town)

**WELL PURPOSE:** Chicken House  
 (home, irrigation, municipal, industrial)

- WELL COMPLETION DATA:**
- (1) diameter (inches) 2"
  - (2) total depth (feet) 150'
  - (3) static water level (feet) 100' <sup>below</sup> above top of ground.
  - (4) casing PVC, 150'  
 (material) (depth)  
2" if telescope see back.  
 (size)
  - (5) screen 10', 140'  
 (length) (depth to top)  
2", PVC  
 (size) (material)
  - (6) pump 1, 6  
 (HP) (yield gpm)  
Elec.  
 (type power)
  - (7) electric log \_\_\_\_\_  
 (yes or no)  
 \_\_\_\_\_  
 (organization running log)
  - (8) how well bottom plugged cap

**DRILLERS REMARKS:** Sand at 390' very fine supplies little water.


**RECEIVED**

DEC 19 1986

Department of Natural Resources  
 Bureau of Land & Water Resources

If well telescopes please sketch and show depths.

GROUND LEVEL

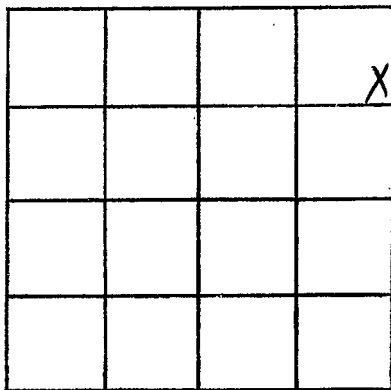

SECTION 19

Please indicate well location X.

ADDITIONAL INFORMATION

If more than one screen,  
show locations of each on sketch.