

SMITH MISSISSIPPI BOARD OF WATER COMMISSIONERS

3 D2
6-24-63

WATER WELL DRILLERS LOG

Smith
Scott

Date: 6/24, 1963, Driller: Faust Dwyer, County: Smith


(1) Owner of Land: A.W. Roberts
(Name)
Rt 1 Faust, Miss.
(Address)
(2) Location: SEC 31 NE 1/4, Sec. 31 T41R9E
(3) Topography: X
(Hilly) (Flat) (Level)
(4) Purpose of Well: Children
(Domestic Irrigation
Municipal, Industrial, Other)

Description & Color of Materials Sand, Clay, Red Clay, Shell, etc.	Thick- ness Feet	Depth Feet
Red Clay	8	12
Clay		32
Clay + mdy sand		42
Blue clay		298
Clay + rock		302
Shale + rock		313
Shale + sth rock		343
Shale		453
Shale + sth fine sand		463
Shale + sth rock		473
Shale		493
Fine sand + shale		503
Shale		528
Fine sand + sth clay		543
Fine sand		550

Information upon completion of well:

(1) Diameter: 2" inches.
(2) Total Depth: 550 feet.
(3) Water Level: 83 feet below top of ground.
(4) Cased to: 535, Size: 2"
(5) Screen: Size: 2", Length: 15ft.
(6) Were any formations sealed against pollution?
yes, 8 no.

2 wells at this loc
SP Cond 400

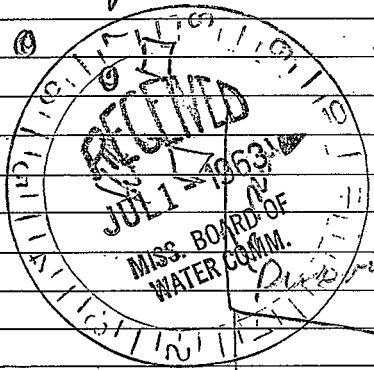

If YES depth of formation
Why: Air Comp
3 hp.
Drillers Remarks:
No stain
Sept.
Sept.

D2 ✓

(Use Back Side)

Well No.

9 hours

