

SMITH  
AD3  
6-12-62

WATER WELL DRILLERS LOG

Date: 6/12, 1962, Driller: FOREST DRILLING SERVICE  
231 Highway 35 North County Scott  
FOREST, MISSISSIPPI

(1) Owner of Land: W. S. Foust, Jr.  
(Name)

(Address)

(2) Location: 1/4, 1/4, Sec. 10 T 40 R 10  
15 miles South, of Fruit  
(distance) (direction) (Nearest Town)

(3) Topography: X  
(Hilly) (Flat) (Level)

(4) Purpose of Well: Rea Park  
(Domestic Irrigation  
Municipal, Industrial, Other)

Description & Color of Materials Sand, Clay, Red Clay, Shell, etc.	Thick- ness Feet	Depth Feet
<u>Brown Clay</u>	<u>0</u>	<u>23</u>
<u>Blue Clay</u>	<u>0.5</u>	<u>148</u>
<u>Clay &amp; Shale</u>	<u>1.87</u>	<u>207</u>
<u>Clay</u>	<u>1.0</u>	<u>217</u>
<u>Clay + Shale</u>	<u>1.0</u>	<u>227</u>
<u>Shale</u>	<u>2.0</u>	<u>247</u>
<u>Fine sand</u>	<u>1.7</u>	<u>264</u>
<u>Clay</u>	<u>3</u>	<u>267</u>
<u>Fine sand</u>	<u>1.0</u>	<u>277</u>
<u>Fine sand</u>	<u>1.1</u>	<u>288</u>

Information upon completion of well:

(1) Diameter 2" inches.

(2) Total Depth 288 feet.

(3) Water Level 60 feet below top of ground.

(4) Cased to 278, Size 2"


(5) Screen: Size 2", Length 10

(6) Were any formations sealed against pollution?  
\_\_\_\_\_ yes, X no.

If YES depth of formation \_\_\_\_\_

Why \_\_\_\_\_

Drillers Remarks: \_\_\_\_\_

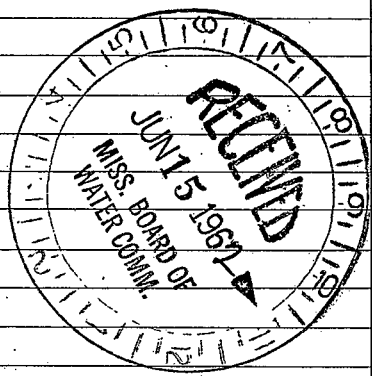

(Use Back Side)

Well No.

