

SMITH
D 6
368

MISSISSIPPI
BOARD OF WATER COMMISSIONERS
416 North State Street
Jackson, Mississippi 39201

WATER WELL DRILLERS LOG

March 19 68 date well completed
Wilkeson Drilling firm name
Smith county well located

LANDOWNER: Sam Hornsby
Raleigh Miss

(mailing address)

WELL LOCATION:

sec 4 T 4 N R 9 E
S W
8 miles N.E. of Paducah
(distance) (direction) (nearest town)

WELL PURPOSE: home
(home, irrigation, municipal, industrial)


WELL COMPLETION DATA:

- (1) diameter (inches) 2
- (2) total depth (feet) 405
- (3) static water level (feet) 68 below above top of ground.
- (4) casing GALV. 399 (material) (depth)
2 (size) if telescope see back.
- (5) screen 6 399 (length) (depth to top)
2 BRASS (size) (material)
- (6) pump 2 15 (HP) (yield gpm)
Elec. (type power)
- (7) electric log NO (yes or no)
(organization running log)
- (8) how well bottom plugged 2-2" B.W.G.

description of formations encountered

from to

yellow clay	0	30
blue clay	30	80
Rock	80	84
blue clay	84	190
sand & shale	190	250
sand Rock & shale	250	300
Shale brown	300	340
sand	340	410

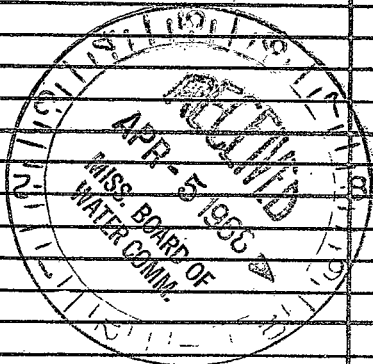

DRILLERS REMARKS:

