

**MISSISSIPPI  
BOARD OF WATER COMMISSIONERS**  
416 North State Street  
Jackson, Mississippi 39201

CODED

**WATER WELL DRILLERS LOG**

Smith  
D10.  
2-69

Feb 1969 Wilkinson Drilling Smith  
date well completed firm name county well located

LANDOWNER: C.D. Harris

description of formations encountered	from	to
<u>Red sand &amp; clay</u>	<u>0</u>	<u>20</u>
<u>Red clay</u>	<u>20</u>	<u>25</u>
<u>Blue clay</u>	<u>25</u>	<u>80</u>
<u>Rock</u>	<u>80</u>	<u>83</u>
<u>Blue clay</u>	<u>83</u>	<u>212</u>
<u>Rock</u>	<u>212</u>	<u>215</u>
<u>Blue clay</u>	<u>215</u>	<u>340</u>
<u>Sand &amp; shale</u>	<u>340</u>	<u>360</u>
<u>Brown shale &amp; clay</u>	<u>360</u>	<u>450</u>
<u>SAND</u>	<u>450</u>	<u>490</u>

Lake Miss  
(mailing address)

WELL LOCATION:

sec. 32 T 4 N R 9 E  
S W  
3 miles North of Pinckville  
(distance) (direction) (nearest town)

WELL PURPOSE: home  
(home, irrigation, municipal, industrial)

WELL COMPLETION DATA:

- (1) diameter (inches) 2
- (2) total depth (feet) 487
- (3) static water level (feet) 126 below top of ground. above
- (4) casing Galv, 482  
(material) (depth)  
         if telescope see back.  
(size)
- (5) screen 5, 487  
(length) (depth to top)  
2, Standard Steel  
(size) (material)
- (6) pump 3, 14  
(HP) (yield gpm)  
slec  
(type power)
- (7) electric log NO  
(yes or no)  
          
(organization running log)
- (8) how well bottom plugged 2" B.W.U.

CODED


MAR 5 1969

DRILLERS REMARKS:

MISS. BD. OF  
WATER CONTROL

If well telescopes please sketch and show depths.

GROUND LEVEL

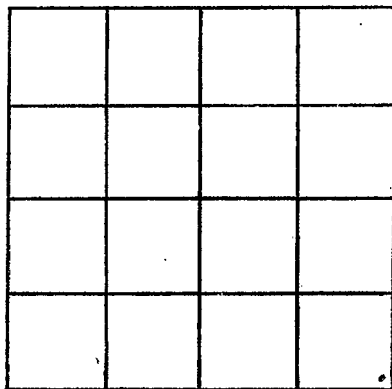

SECTION 32

Please indicate well location X.

ADDITIONAL INFORMATION

If more than one screen,  
show locations of each on sketch.