

MISSISSIPPI
BOARD OF WATER COMMISSIONERS
416 North State Street
Jackson, Mississippi 39201

CODED

WATER WELL DRILLERS LOG

Smith
D 11
1-70

Jan 1970 date well completed
Wilkeson Drilling firm name
Smith county well located

LANDOWNER: Mr Robert Carr
Forest Mills
(mailing address)

description of formations encountered	from	to
Red clay sand	0	50
Blue	50	300
Rock & clay	310	380
Brown v	380	410
SAND	410	500

WELL LOCATION:
sec. 19 T-4 N R-9 E
6 miles N of Pineville
(distance) (direction) (nearest town)

WELL PURPOSE: Home
(home, irrigation, municipal, industrial)

- WELL COMPLETION DATA:
- (1) diameter (inches) 2
 - (2) total depth (feet) 479
 - (3) static water level (feet) 131 below top of ground.
 - (4) casing GALV, 474, (material) (depth)
 - (size) if telescope see back.
 - (5) screen 5, 479 (length) (depth to top)
 - 2, 2 Strainers (size) (material)
 - (6) pump 3, 12 (HP) (yield gpm)
 - Elec (type power)
 - (7) electric log No (yes or no)

(organization running log)

(8) how well bottom plugged 2B.W.U.

WAR 10 1970


DRILLERS REMARKS:

MISS. BD. OF
WATER

CODED

If well telescopes please sketch and show depths.

GROUND LEVEL

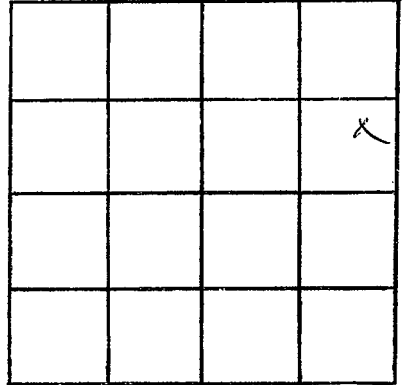

SECTION 19

Please indicate well location X.

ADDITIONAL INFORMATION

If more than one screen,
show locations of each on sketch.