

SMITH
D12
10-27-72

MISSISSIPPI
 BOARD OF WATER COMMISSIONERS
 416 North State Street
 Jackson, Mississippi 39201

COPIED

WATER WELL DRILLERS LOG

Oct 27 19 72 Wilkinson Drill. Sew. Smith
 date well completed firm name county well located

LANDOWNER: Glen Burnett

Route 1
Louis, Miss
 (mailing address)

description of formations encountered	from	to
<u>Red sand</u>	<u>0</u>	<u>40</u>
<u>Blue clay</u>	<u>40</u>	<u>420</u>
<u>Layers Rock</u>	<u>420</u>	<u>470</u>
<u>White sand</u>	<u>470</u>	<u>480</u>
<u>Water sand</u>	<u>480</u>	<u>570</u>

WELL LOCATION:
 sec. 26 T. 8 N. R. 9E
4 miles N.W. of Louis
 (distance) (direction) (nearest town)

WELL PURPOSE: Dom
 (home, irrigation, municipal, industrial)

WELL COMPLETION DATA:

- (1) diameter (inches) 2
- (2) total depth (feet) 570
- (3) static water level (feet) 112 below above top of ground.
- (4) casing Galv. 570
 (material) (depth)
 (size) If telescope see back.
- (5) screen 10' 2"
 (length) (depth to top) (size) (material) St. Steel
- (6) pump 3 Elec.
 (HP) (yield gpm) (type power)
- (7) electric log no
 (yes or no)
- (8) how well bottom plugged B.W.V.

COPIED


OCT 27 1972

MISSISSIPPI
 BOARD OF WATER COMMISSIONERS

DRILLERS REMARKS:

If well telescopes please sketch and show depths.

GROUND LEVEL

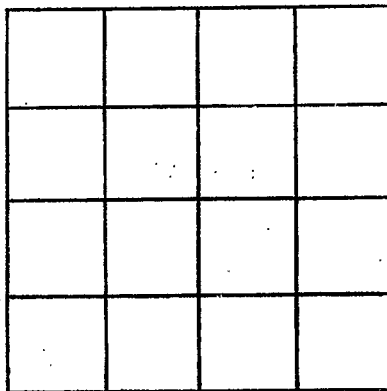

SECTION _____

Please indicate well location X.

ADDITIONAL INFORMATION

A series of horizontal lines for entering additional information, starting below the 'ADDITIONAL INFORMATION' header and extending to the bottom of the page.

If more than one screen, show locations of each on sketch.