

SMITH
D 13
10-30-72

MISSISSIPPI
 BOARD OF WATER COMMISSIONERS
 416 North State Street
 Jackson, Mississippi 39201

WATER WELL DRILLERS LOG

CODED

Oct. 30 1972 Wilkinson Drilling & Smith county well located
 date well completed firm name

LANDOWNER: Billie B. Harris

description of formations encountered

from to

Route ~~20~~ 2
Lake, Miss
 (mailing address)

<u>yellow clay</u>	<u>0</u>	<u>20</u>
<u>Blue clay</u>	<u>20</u>	<u>450</u>
<u>Roofs</u>	<u>450</u>	<u>500</u>
<u>Sand</u>	<u>500</u>	<u>525</u>

WELL LOCATION:

sec. 5 T 4 N R 9 E
12 miles SW of Lake
 (distance) (direction) (nearest town)

WELL PURPOSE: Home
 (home, irrigation, municipal, industrial)

CODED

WELL COMPLETION DATA:

- (1) diameter (inches) 2
- (2) total depth (feet) 525
- (3) static water level (feet) 135 below above top of ground.
- (4) casing Galv. (material) (depth)
 (size) if telescope see back.
- (5) screen 10' (length) (depth to top)
2 (size) St. Steel (material)
- (6) pump 3 (HP) (yield gpm)
Elec. (type power)
- (7) electric log no (yes or no)
 (organization running log)
- (8) how well bottom plugged B.W.V.


OCT 31 1972

MISS. L. WATER COM.

DRILLERS REMARKS:

If well telescopes please
sketch and show depths.

GROUND LEVEL

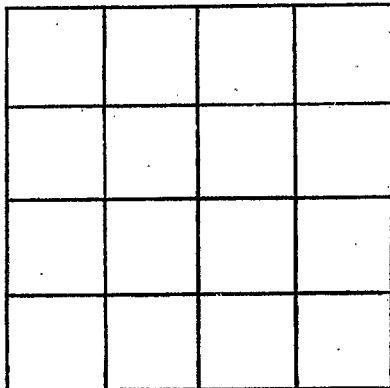

SECTION _____

Please indicate well location X.

ADDITIONAL INFORMATION

If more than one screen,
show locations of each on sketch.