

Smith
D 2000
4-28-76

MISSISSIPPI
BOARD OF WATER COMMISSIONERS
416 North State Street
Jackson, Mississippi 39201

WATER WELL DRILLERS LOG

4-28 1976 *W. Wilkenson Drill. Inc.* *Smith Co.*
date well completed firm name county well located

LANDOWNER:
Tom Fountain
Lake, Miss, Route 2
(mailing address)

description of formations encountered	from	to
<i>Willow Clay</i>	0	20
<i>Black "</i>	20	70
<i>yellow "</i>	70	80
<i>Black "</i>	80	147
<i>BL Rocks</i>	147	310
<i>BL S</i>	310	378
<i>Sandy</i>	378	388
<i>sandy</i>	388	410
<i>sand</i>	410	425

WELL LOCATION:
sec. *4* T. *4N* R. *9E*
15 miles *S* of *Lake*
(distance) (direction) (nearest town)

WELL PURPOSE:
(home, irrigation, municipal, industrial)

WELL COMPLETION DATA:

(1) diameter (inches) *2"*

(2) total depth (feet) *425*

(3) static water level (feet) *84* below above top of ground.

(4) casing *Galv.* *420*
(material) (depth)

_____ if telescope see back.
(size)

(5) screen *5'*
(length) (depth to top)
2" *S. Steel*
(size) (material)

(6) pump *3*
(HP) (yield gpm)
Elec.
(type power)

(7) electric log *no*
(yes or no)

_____ (organization running log)

(8) how well bottom plugged *B.W.U*


MAY 12 1976

MISS. BD. OF WATER COMMISSIONERS

DRILLERS REMARKS:

If well telescopes please sketch and show depths.

GROUND LEVEL

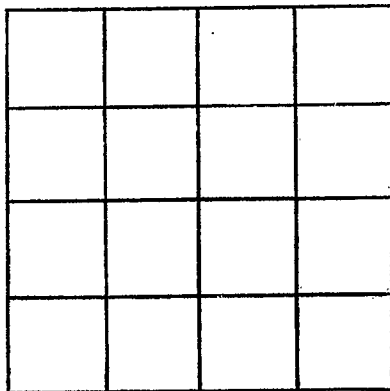

SECTION _____

Please indicate well location X.

ADDITIONAL INFORMATION

If more than one screen, show locations of each on sketch.