

Smith  
D2001  
8-2-79

MISSISSIPPI  
 BOARD OF WATER COMMISSIONERS  
 416 North State Street  
 Jackson, Mississippi 39201

WATER WELL DRILLERS LOG

SMITH

8-2 1979 W.K. BARNE & W. SMITH CO.  
 date well completed firm name county well located

LANDOWNER:	description of formations encountered	from	to
<u>James Macintosh</u>	<u>Red clay</u>	<u>0</u>	<u>20</u>
<u>Pisville, Miss</u> (mailing address)	<u>White sand</u>	<u>20</u>	<u>30</u>
WELL LOCATION:	<u>Blue clay</u>	<u>30</u>	<u>200</u>
sec. <u>31</u> T. <u>4</u> S R. <u>9</u> E	<u>Shells Rock</u>	<u>200</u>	<u>250</u>
<u>10</u> miles <u>N.E.</u> of <u>Sylvania</u>	<u>SANDS Shell</u>	<u>250</u>	<u>300</u>
(distance) (direction) (nearest town)	<u>fine sand</u>	<u>300</u>	<u>400</u>
WELL PURPOSE: <u>Chicken House</u> (home, irrigation, municipal, industrial)	<u>medium sand</u>	<u>400</u>	<u>420</u>
WELL COMPLETION DATA:			
(1) diameter (inches) <u>2 1/2</u>			
(2) total depth (feet) <u>420 feet</u>			
(3) static water level (feet) <u>30</u> below top of ground.			
(4) casing <u>Galv</u> (material), <u>420</u> (depth)			
<u>2 1/2</u> (size) If telescope see back.			
(5) screen <u>10 ft</u> (length), <u>Shells Shell</u> (depth to top)			
<u>2 1/2</u> (size), <u>Stainless Steel</u> (material)			
(6) pump <u>1 1/2</u> (HP), <u>12</u> (yield gpm)			
<u>FOT</u> (type power)			
(7) electric log <u>NO</u> (yes or no)			
(organization running log)			
(8) how well bottom plugged <u>wash</u>			
<u>1/2 inches</u>			
DRILLERS REMARKS:			


Miss. Board of Water Comm.

SEP 10 1979

RECEIVED

If well telescopes please sketch and show depths.

GROUND LEVEL

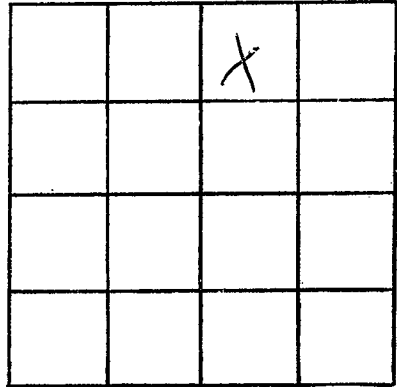

SECTION \_\_\_\_\_

Please indicate well location X.

ADDITIONAL INFORMATION

Lined area for additional information.

If more than one screen, show locations of each on sketch.