

BOARD OF WATER COMMISSIONERS
 416 North State Street
 Jackson, Mississippi 39201

WATER WELL DRILLERS LOG

date well completed

firm name

county well located

2/26/85 *Layne-Central*

Smith

LANDOWNER:

White Oak W. A.

(mailing address)

WELL LOCATION:

sec. _____ T. _____ N. _____ R. _____ E. _____
 S. _____ W. _____

(distance) _____ miles (direction) _____ of (nearest town) _____

WELL PURPOSE:

(home, irrigation, municipal, industrial)

WELL COMPLETION DATA:

- (1) diameter (inches) _____
- (2) total depth (feet) _____
- (3) static water level (feet) _____ below above top of ground.
- (4) casing _____ (material) _____ (depth) _____
 _____ (size) if telescope see back.
- (5) screen _____ (length) _____ (depth to top) _____
 _____ (size) _____ (material) _____
- (6) pump _____ (HP) _____ (yield gpm) _____
 _____ (type power) _____
- (7) electric log _____ (yes or no) _____
 _____ (organization running log) _____
- (8) how well bottom plugged _____

description of formations encountered

from

to

<i>rock</i>	<i>1173</i>	<i>1174</i>
<i>hard clay</i>	<i>1174</i>	<i>1175</i>
<i>rock</i>	<i>1175</i>	<i>1178</i>
<i>clay</i>	<i>1178</i>	<i>1229</i>
<i>rock & clay</i>	<i>1229</i>	<i>1276</i>
<i>sandy clay</i>	<i>1276</i>	<i>1279</i>
<i>fine sand & clay</i>	<i>1279</i>	<i>1302</i>
<i>fine sand & clay</i>	<i>1302</i>	<i>1332</i>
<i>fine sand & clay</i>	<i>1332</i>	<i>1337</i>
<i>sandy clay</i>	<i>1337</i>	<i>1377</i>
<i>sand & clay</i>	<i>1377</i>	<i>1387</i>
<i>clay & lignite</i>	<i>1387</i>	<i>1431</i>
<i>fine sand & clay</i>	<i>1431</i>	<i>1456</i>
<i>clay</i>	<i>1456</i>	<i>1545</i>
<i>rock</i>	<i>1545</i>	<i>1556</i>
<i>clay</i>	<i>1556</i>	<i>1558</i>
<i>sandy clay</i>	<i>1558</i>	<i>1606</i>

RECEIVED

MAR 4 - 1985


Department of Natural Resources
 Bureau of Land & Water Resources

DRILLERS REMARKS:

If well telescopes please sketch and show depths.

GROUND LEVEL

55'
5.
175' ml 3' (1)
55'

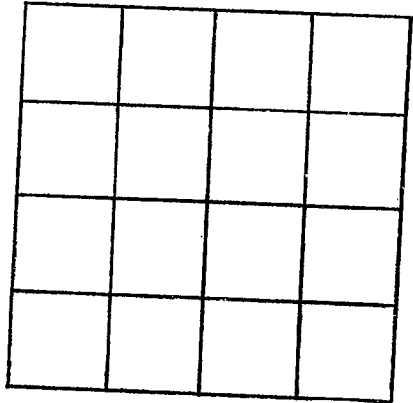

SECTION _____

Please indicate well location X.

ADDITIONAL INFORMATION

A series of horizontal lines for recording additional information.

If more than one screen, show locations of each on sketch.