

Smith  
3 EL  
11-66

T

MISSISSIPPI BOARD OF WATER COMMISSIONERS

WATER WELL DRILLERS LOG

Date: Nov 10, 1966, Driller: W. G. Butler County Smith  
(When well drilled) (Name) (Where well is located)


(1) Owner of Land: Norman Adcock  
(Name)  
MORTON, MISS. Rt. 4 -  
(Address)  
 (2) Location: SE 1/4, NE 1/4, Sec. 10 T. 3R. 6E  
4 1/2 miles North of White Oak  
(distance) (direction) (Nearest Town)  
 (3) Topography:  (Hilly)  (Flat)  (Level)  
 (4) Purpose of Well: Domestic  
(Domestic Irrigation, Municipal, Industrial, Other)

Description & Color of Materials Sand, Clay, Red Clay, Shell, etc.	Thick- ness Feet	Depth Feet
Red Clay	5	5
Chalk	45	50
Brown Chalk	40	90
Shell + chalk	10	100
Rock + shell	40	140
shell + chalk	10	150
Shell + lignite	10	160
Shell + Chalk	10	170
Chalk	10	180
Fine sand + Chalk	10	190
Chalk	42	232
Fine sand	21	253
Blue Chalk	63	316
Blue Chalk, shale, shell	105	421

Information upon completion of well:

(1) Diameter 2" inches.  
 (2) Total Depth 421 feet.  
 (3) Water Level 75 feet below top of ground.  
 (4) Cased to 134, Size 2"  
 (5) Screen: Size open Hole, Length \_\_\_\_\_  
 (6) Were any formations sealed against pollution?  
 \_\_\_\_\_ yes,  no.

YES depth of formation \_\_\_\_\_  
 Why \_\_\_\_\_  
 Drillers Remarks: \_\_\_\_\_  
 Yield in gpm: 10  
 Size pump: 2 HP - 3 stage  
 Type power: Electric

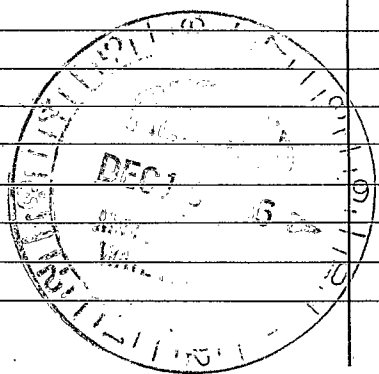

1