

B E 5

4-3-65

WATER WELL DRILLERS LOG

Date: April 3 19 65, Driller: W. G. Butler, County Smith  
 (Name)


(1) Owner of Land Rock Bluff Church  
 (Name)  
Morton, Rt. 4  
 (Address)  
 (2) Location: NW 1/4, SE 1/4, Sec. 6, T32R6E  
 (distance) miles \_\_\_\_\_, of \_\_\_\_\_, of \_\_\_\_\_  
 (direction) (Nearest Town)  
 (3) Topography:  (Hilly)  (Flat)  (Level)  
 (4) Purpose of Well: Domestic  
 (Domestic Irrigation, Municipal, Industrial, Other)

Description & Color of Materials Sand, Clay, Red Clay, Shell, etc.	Thick- ness Feet	Depth Feet
Chalk	1	10
Red sand	10	20
Chalk	20	25
ROCK	25	55
Chalk + shell	55	70
Chalk	70	80
Shale, sand + Chalk	80	90

Information upon completion of well:

(1) Diameter 2" inches.  
 (2) Total Depth 190 feet.  
 (3) Water Level \_\_\_\_\_ feet below top of ground. 25' 4" casing  
 (4) Cased to 147, Size 2"  
 (5) Screen: Size 2", Length 10'  
 (6) Were any formations sealed against pollution?  
 \_\_\_\_\_ yes, \_\_\_\_\_ no.

If YES depth of formation \_\_\_\_\_  
 Why \_\_\_\_\_  
 Drillers Remarks: \_\_\_\_\_

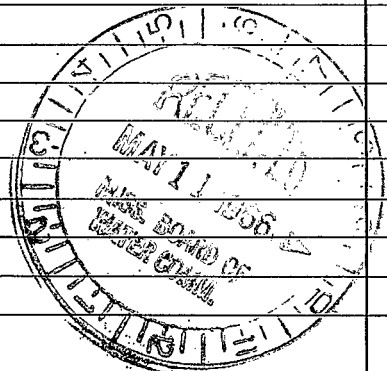

(Use Back Side)

Well No.

1950

1950

