

SMITH

MISSISSIPPI BOARD OF WATER COMMISSIONERS

E7
6-4-64

WATER WELL DRILLERS LOG

Date: June 4, 1964 Driller: W. H. Butler County: Smith
(Name)

(1) Owner of Land: J.A. Derrick
(Name)
Margie Rtz. Miss
(Address)

(2) Location: 1/4, 1/4, Sec 29 B1/4
1 miles in → of White Oak
(distance) (direction) (Nearest Town)

(3) Topography: Level
(Hilly) (Flat) (Level)

(4) Purpose of Well: Domestic
(Domestic Irrigation
Municipal, Industrial, Other)


Description & Color of Materials Sand, Clay, Red Clay, Shell, etc.	Thick- ness Feet	Depth Feet
Chalk	2	20
Sand	20	70
Chalk + sand	20	80
Chalk	80	150
Rock, Chalk + Shell	100	110
Rock, Chalk, Fine Sand	110	120
Rock + Chalk	120	140
Chalk	140	150
Chalk, Shell, Lignite	150	160
Shell + Sand	160	170
Shell + Chalk	170	180
Shell + Lignite	180	190
Chalk + Sand	190	222
Sand	222	253

Information upon completion of well:

- (1) Diameter 2 inches.
- (2) Total Depth 253 feet.
- (3) Water Level 30 feet below top of ground.
- (4) Cased to 222, Size 2"
- (5) Screen: Size 2, Length 5'
- (6) Were any formations sealed against pollution?
_____ yes, _____ no.

If YES depth of formation _____
Why _____

Drillers Remarks: _____

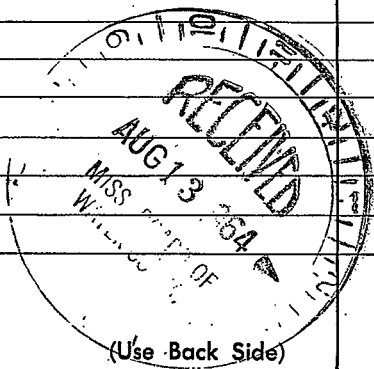

Well No. _____

... ..

... ..

...

...

...

... ..

...

...

