

T

WATER WELL DRILLERS LOG

Date: Aug 6, 1963, Driller: W. G. Butler County Smith

(Name)

(1) Owner of Land: Vick Purvis  
(Name)

Morton, Miss, Rtu  
(Address)

(2) Location: 1/4, 1/4, Sec. 8 T3 R6E

7 miles North of Whitman  
(distance) (direction) (Nearest Town)

(3) Topography:  (Hilly)  (Flat)  (Level)

(4) Purpose of Well: Domestic  
(Domestic Irrigation, Municipal, Industrial, Other)

Information upon completion of well:

(1) Diameter 2 inches.

(2) Total Depth 180 feet.

(3) Water Level \_\_\_\_\_ feet below top of ground.

(4) Cased to 168', Size 2"

(5) Screen: Size 2", Length 10'


(6) Were any formations sealed against pollution?  
\_\_\_\_\_ yes, \_\_\_\_\_ no.

If YES depth of formation \_\_\_\_\_

Why \_\_\_\_\_

Drillers Remarks: \_\_\_\_\_

Description & Color of Materials Sand, Clay, Red Clay, Shell, etc.	Thick- ness Feet	Depth Feet
Red Clay	1-5	
Chalk	5-15	
Chalk + Sand	15-20	
Shell + Sand	20-30	
Rock	30-70	
Gray Chalk	70-90	
Chalk	90-100	
Chalk + Lignite	100-120	
Fine Sand + Chalk	120-130	
Chalk	130-140	
Sand	140-150	
Sand + Lignite	150-160	
Sand	160-170	
Good Sand	170-180	

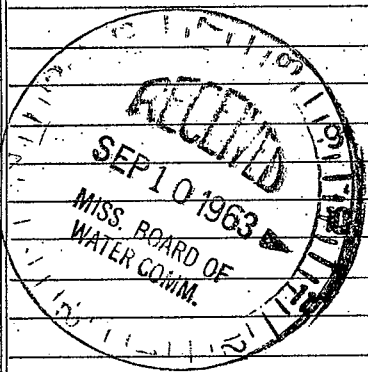

(Use Back Side)

Well No.

*[The page contains extremely faint and illegible text, likely bleed-through from the reverse side of the document. The text is scattered across the page and does not form any recognizable words or sentences.]*