

SMITH
S E 12

WATER WELL DRILLERS LOG

T 4
6

Date: Nov. 18-18 1961, Driller: W. G. Butler County Smith
(Name)

(1) Owner of Land: JUNIOR PURVIS
(Name)

Polkville, Miss
(Address)

(2) Location: 1/4, 1/4, Sec. 16 T3 R6 E
8 miles South of Polkville
(distance) (direction) (Nearest Town)

(3) Topography: (Hilly) (Flat) (Level)

(4) Purpose of Well: Domestic
(Domestic Irrigation
Municipal, Industrial, Other)

Information upon completion of well:

(1) Diameter 2 inches.

(2) Total Depth 200 feet.

(3) Water Level 30 feet below top of ground.

(4) Cased to 189, Size 2"

(5) Screen: Size 2", Length 5'


(6) Were any formations sealed against pollution?
 yes, no.

If YES depth of formation _____

Why _____

Drillers Remarks: _____

Description & Color of Materials Sand, Clay, Red Clay, Shell, etc.	Thick- ness Feet	Depth Feet
Clay	0-2	
Chalk	2-20	
Sand	20-25	
Chalk	25-57	
Shale	57-60	
Rock + shale	60-90	
" "	90-100	
Blue Gumbo	100-120	
Gumbo + Shale	120-150	
Chalk	150-155	
little sand	155-160	
More sand	160-170	
sand	170-200	

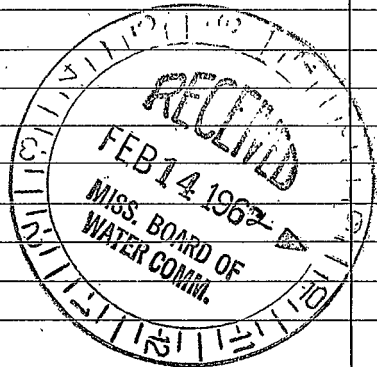

(Use Back Side)

Well No.

