

SMITH

3

E 13

5-6-63

May 6

63

WATER WELL DRILLERS LOG

W. H. Butler

Smith

Date: _____, 19____, Driller: _____ County _____

(Name)

	Description & Color of Materials Sand, Clay, Red Clay, Shell, etc.	Thick- ness Feet	Depth Feet
(1) Owner of Land: _____ (Name) Magee, Mrs Miss	Red Clay SAND	10	96
(Address) _____			
(2) Location: _____ 1/4, _____ 1/4, Sec. 20 T3 R7 1/4 North White oak _____ miles _____ of _____ (distance) (direction) (Nearest Town)			
(3) Topography: _____ (Hilly) Domestic (Flat) (Level)			
(4) Purpose of Well: _____ (Domestic Irrigation Municipal, Industrial, Other)			

Information, upon completion of well:

(1) Diameter _____ inches. 2 1/6

(2) Total Depth _____ feet. 50

(3) Water Level _____ feet below top of ground. 68 2"

(4) Cased to _____, Size _____ 6'

(5) Screen: Size _____, Length _____


(6) Were any formations sealed against pollution?

_____ yes, _____ no.

If YES depth of formation _____

Why _____

Drillers Remarks: _____

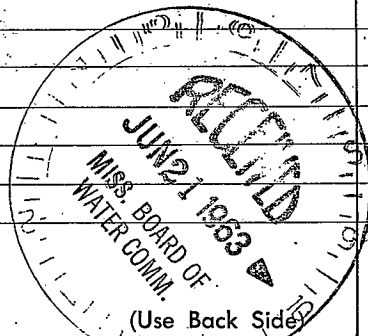

Well No. _____

