

6 E14
2-27-63

WATER WELL DRILLERS LOG


Date: Feb 27, 1963, Driller: W. G. Butler County Smith
(Name)

(1) Owner of Land:	Description & Color of Materials Sand, Clay, Red Clay, Shell, etc.	Thick- ness Feet	Depth Feet
John H. Duke (Name) Morton, Rt 4 Miss (Address)	Chalk Rock	1-8 8-10	
(2) Location: 1/4, 1/4, Sec. 28 N, T3 R6 E 10 miles West of Raleigh, (distance) (direction) (Nearest Town)	Rock + Chalk Sand + Rock Sand	10-30 30-40 40-45	
(3) Topography: <input checked="" type="checkbox"/> (Hilly) <input type="checkbox"/> (Flat) <input type="checkbox"/> (Level)			
(4) Purpose of Well: Domestic (Domestic Irrigation Municipal, Industrial, Other)			

Information upon completion of well:

- (1) Diameter 2 inches.
- (2) Total Depth 45 feet.
- (3) Water Level 20 feet below top of ground.
- (4) Cased to 40', Size 2"
- (5) Screen: Size 2", Length 5'
- (6) Were any formations sealed against pollution?
_____ yes, _____ no.

If YES depth of formation _____
Why _____
Drillers Remarks: _____

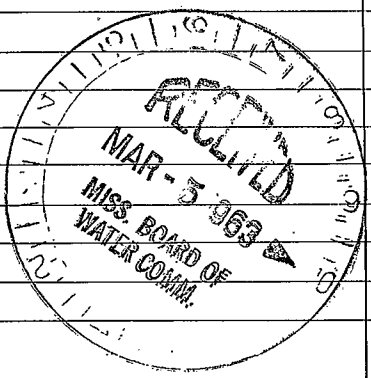

(Use Back Side)

Retain this copy for your office files.

Well No.

