

SMITH


T

WATER WELL DRILLERS LOG

Date: Sept. 7, 1962 Driller: W. G. Butler County Smith

(Name)

(1) Owner of Land: <u>Noble Beavers</u> (Name)	Description & Color of Materials Sand, Clay, Red Clay, Shell, etc.	Thick- ness Feet	Depth Feet
<u>Mortun, Miss. Rt. 4</u> (Address)	<u>Chalk</u>	<u>1-10</u>	<u>10</u>
(2) Location: <u>1/4</u> , <u>1/4</u> , Sec. <u>27 T3 R6E</u>	<u>sand</u>	<u>10-15</u>	<u>15</u>
<u>1/8</u> miles <u>West</u> of <u>Raleigh</u> (distance) (direction) (Nearest Town)	<u>Rock</u>	<u>15-16</u>	<u>16</u>
(3) Topography: <input checked="" type="checkbox"/> (Hilly) <input type="checkbox"/> (Flat) <input type="checkbox"/> (Level)	<u>Chalk</u>	<u>16-20</u>	<u>20</u>
(4) Purpose of Well: <u>Domestic</u> (Domestic Irrigation Municipal, Industrial, Other)	<u>Chalk + sand</u>	<u>20-25</u>	<u>25</u>
Information upon completion of well:	<u>Rock</u>	<u>25-27</u>	<u>27</u>
(1) Diameter <u>2</u> inches.	<u>Chalk</u>	<u>27-30</u>	<u>30</u>
(2) Total Depth <u>80</u> feet.	<u>sand</u>	<u>30-36</u>	<u>36</u>
(3) Water Level _____ feet below top of ground.	<u>Rock</u>	<u>36-42</u>	<u>42</u>
(4) Cased to <u>4:21</u> , Size <u>2"</u>	<u>sand</u>	<u>42-44</u>	<u>44</u>
(5) Screen: Size <u>2"</u> , Length <u>5'</u>	<u>Rock</u>	<u>44-45</u>	<u>45</u>
(6) Were any formations sealed against pollution? _____ yes, _____ no.	<u>sand</u>	<u>45-49</u>	<u>49</u>
If YES depth of formation _____	<u>Rock</u>	<u>49-51</u>	<u>51</u>
Why _____	<u>Gray Chalk</u>	<u>51-70</u>	<u>70</u>
Drillers Remarks: _____	<u>Blue Chalk</u>	<u>70-80</u>	<u>80</u>

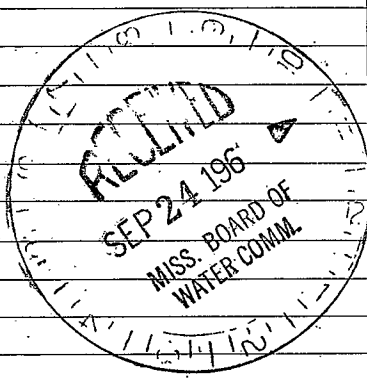

(Use Back Side)

Well No.

