

SMITH  
 5 E 18  
 9-6-62

MISSISSIPPI BOARD OF WATER COMMISSIONERS

T

WATER WELL DRILLERS LOG

Date: Sept. 6, 1962 Driller: W. G. Butler County: SMITH  
 (Name)

(1) Owner of Land: Roy Cook  
 (Name)  
Magee, Miss, Rt. 3  
 (Address)

(2) Location: 1/4, 1/4, Sec. 31 T3N R6E  
3 miles East of Pockett  
 (distance) (direction) (Nearest Town)

(3) Topography:  (Hilly)  (Flat)  (Level)

(4) Purpose of Well: Domestic  
 (Domestic Irrigation  
 Municipal, Industrial, Other)

Description & Color of Materials Sand, Clay, Red Clay, Shell, etc.	Thick- ness Feet	Depth Feet
Red Clay	1-	10
Red Sand	10-	20
Chalk + Sand	20-	30
Sand	30	35
Rock + Chalk	35-	50
Rock	50	65
Rock + Chalk	65	70
Chalk	70	75
Sand + Chalk	75	80
Sand	80-	103 1/2

Information upon completion of well:

(1) Diameter 2 inches.

(2) Total Depth 103 1/2 feet.

(3) Water Level \_\_\_\_\_ feet below top of ground.

(4) Cased to 97, Size 2"


(5) Screen: Size 2", Length 5'

(6) Were any formations sealed against pollution?  
 \_\_\_\_\_ yes, \_\_\_\_\_ no.

If YES depth of formation \_\_\_\_\_

Why \_\_\_\_\_

Drillers Remarks: \_\_\_\_\_

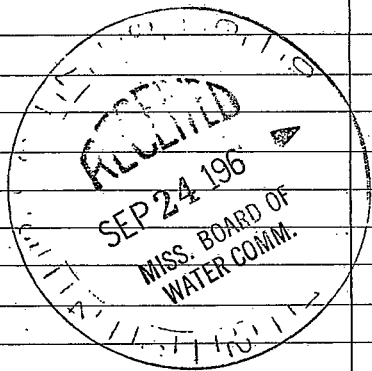

(Use Back Side)

Well No.

1911

1912

1913

1914