

5 E19
9-3-62

WATER WELL DRILLERS LOG

Date: Sept. 5, 1962, Driller: W. G. Butler County Smith
(Name)

(1) Owner of Land: Wayne Milton
(Name)
Morton, Miss. Rt 4.
(Address)

(2) Location: 1/4, 1/4, Sec. 20 T3 R6E
12 miles N.W. of Raleigh
(distance) (direction) (Nearest Town)

(3) Topography: (Hilly) (Flat) (Level)

(4) Purpose of Well: Domestic
(Domestic Irrigation
Municipal, Industrial, Other)

Description & Color of Materials Sand, Clay, Red Clay, Shell, etc.	Thick- ness Feet	Depth Feet
Red-Clay Sand	7-10	
SAND	10-25	
Gray Chalk	25-75	
Rock	75-105	
Shell + Chalk	105-110	
Shell, Chalk-Sand	110-120	
Fine Sand	120-130	
Fine Sand-Chalk	130-140	
Fine Sand + Lignite	140-150	
SAND	150-157	
Lignite	157-160	
SAND + Chalk	160-170	
Chalk	170-180	
SAND	180-206	

Information upon completion of well:

(1) Diameter 2 inches.

(2) Total Depth 206 feet.

(3) Water Level 20 feet below top of ground.

(4) Cased to 200', Size 2"


(5) Screen: Size 2", Length 10'

(6) Were any formations sealed against pollution?
_____ yes, _____ no.

If YES depth of formation _____

Why _____

Drillers Remarks: _____

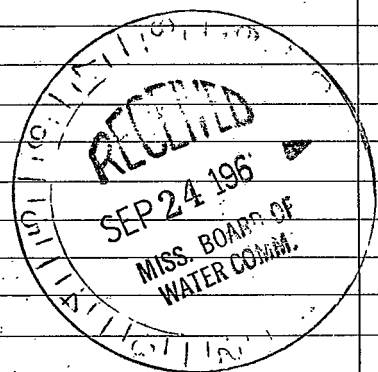

(Use Back Side)

Well No.

