

SMITH

WATER WELL DRILLERS LOG

6306 T

4 E 22
7-3-61

Date: July 3, 1961, Driller: W. G. Butler County Smith
(Name)

(1) Owner of Land: Walter Ray Ware
(Name)
 Magee, Miss. Rt 3
(Address)

(2) Location: N 1/4 SW 1/4, NE 1/4, Sec. 29 T3R6E
1 miles West of White Oak
(distance) (direction) (Nearest Town)

(3) Topography: (Level)
(Hilly) (Flat)

(4) Purpose of Well: Domestic
(Domestic Irrigation
Municipal, Industrial, Other)

Description & Color of Materials Sand, Clay, Red Clay, Shell, etc.	Thick- ness Feet	Depth Feet
Clay	1-	10
Chalk	10-	25
Gumbo	25-	90
Gumbo + shell	90-	102
Rock	100-	130
Shell	130-	140
sand + shell	140-	155
sand + chalk	155-	175
chalk	175-	178
sand	178-	180
"	180-	186

Information upon completion of well:

(1) Diameter 2" inches.

(2) Total Depth 186 feet.

(3) Water Level 30 feet below top of ground.

(4) Cased to 180, Size 2"


(5) Screen: Size 2", Length 6'

(6) Were any formations sealed against pollution?
_____ yes, _____ no.

If YES depth of formation _____

Why _____

Drillers Remarks: _____

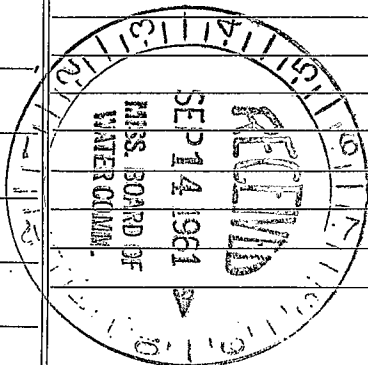

(Use Back Side)

Well No.

