

4 E 25
10-10-60

WATER WELL DRILLERS LOG

E-300

Date: Oct. 16, 1960, Driller: W. G. Butler County Smith

(Name)

(1) Owner of Land: J. M. Duke
(Name)

Polkville, Miss. Rt 1
(Address)

(2) Location: NW 1/4, NW 1/4, Sec. 28 T3R6

11 miles West of Raleigh
(distance) (direction) (Nearest Town)

(3) Topography: (Hilly) (Flat) (Level)

(4) Purpose of Well: Domestic
(Domestic Irrigation
Municipal, Industrial, Other)

Description & Color of Materials Sand, Clay, Red Clay, Shell, etc.	Thick- ness Feet	Depth Feet
Top soil		1
Red clay	17 1/2	20
Dry sand	20 1/2	28
sand + chalk	28 1/2	40
Rock formation	44 1/2	55
sand	55 1/2	58
Rock	58 1/2	60
sand	60 1/2	68

Information upon completion of well:

(1) Diameter 2 inches.

(2) Total Depth 68 feet.

(3) Water Level 48' feet below top of ground.

(4) Cased to 63', Size 2"


(5) Screen: Size 1 1/4", Length 5'

(6) Were any formations sealed against pollution?
no

If YES depth of formation _____

Why _____

Drillers Remarks: _____

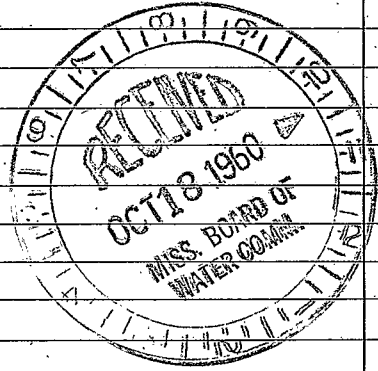

(Use Back Side)

Well No.

