

SMITH MISSISSIPPI BOARD OF WATER COMMISSIONERS

E 26

T

10-28-65 WATER WELL DRILLERS LOG

Date: Oct. 28, 1965, Driller: W. G. Butler County Smith

(Name)

(1) Owner of Land: D. W. Hampton
 (Name)
Morton Rt. 4 - Box
 (Address)

(2) Location: 1/4, 1/4, Sec. 16 T3 N R6 E
2 miles N. of White Oak
 (distance) (direction) (Nearest Town)

(3) Topography: (Hilly) (Flat) (Level)

(4) Purpose of Well: Domestic
 (Domestic Irrigation
 Municipal, Industrial, Other)

Description & Color of Materials Sand, Clay, Red Clay, Shell, etc.	Thick- ness Feet	Depth Feet
Sand	1-25	
Chalk	25-40	
Chalk + Rock	40-60	
Chalk + Sand	60-90	
Chalk	90-110	
Chalk, Rock + Shell	110-120	
Rock + Shell	120-130	
Rock	130-145	
Chalk	145-155	
Chalk + Shell	155-160	
Shell + Lignite	160-170	
Chalk + Sand	170-180	
Chalk	180-228	
Sand	228-233	
Chalk	233-238	
Sand	238-264	

Information upon completion of well:

(1) Diameter 2 inches.

(2) Total Depth 264 feet.

(3) Water Level _____ feet below top of ground.

(4) Cased to 137, Size 2"


(5) Screen: Size 2", Length 5'

(6) Were any formations sealed against pollution?
 _____ yes, _____ no.

If YES depth of formation _____

Why _____

Drillers Remarks: _____

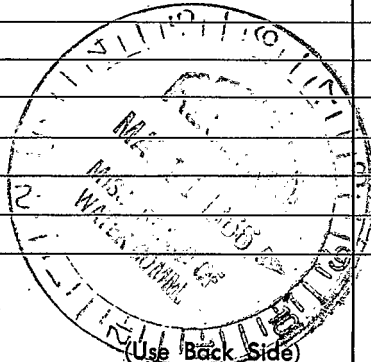

(Use Back Side)

Well No.

Handwritten header text, possibly a date or reference number.

Handwritten text, possibly a name or title.

Vertical column of handwritten text on the left side of the page.

Handwritten text in the middle right section.

Handwritten text in the lower middle right section.