

WATER WELL DRILLERS LOG

E 305

Date: MAY 9, 1961, Driller: W. G. Butler County SMITH
 (Name)

(1) Owner of Land: Houston Purvis
 (Name)

Polkville MISS.
 (Address)

(2) Location: SW 1/4 SE 1/4, Sec. 9 T36E

3 miles North, of White Oak
 (distance) (direction) (Nearest Town)

(3) Topography: (Hilly) (Flat) (Level)

(4) Purpose of Well: Domestic
 (Domestic Irrigation, Municipal, Industrial, Other)

Information upon completion of well:

(1) Diameter 2 inches.

(2) Total Depth 200 feet.

(3) Water Level 65 feet below top of ground.

(4) Cased to 189, Size 2"

(5) Screen: Size 2", Length 1-5' > 11'

(6) Were any formations sealed against pollution?
 _____ yes, _____ no.


If YES depth of formation _____

Why _____

Drillers Remarks: _____

Description & Color of Materials Sand, Clay, Red Clay, Shell, etc.	Thick- ness Feet	Depth Feet
Clay	1-5	
Chalk	5-15	
Chalk + Sand	15-30	
Blue + Black Chalk	30-50	
Chalk	50-57	
Rock	57-60	
Blue Gumbo	60-65	
ROCK	65-90	
Gumbo	90-100	
Chalk	100-120	
Sand + Shell	120-135	
Chalk	135-140	
White + Sand	140-145	
Gumbo	145-150	
Gumbo + Sand	150-160	
Gumbo	160-170	
little sand	175-180	
Sand	180-190	
21	190-200	

E 3

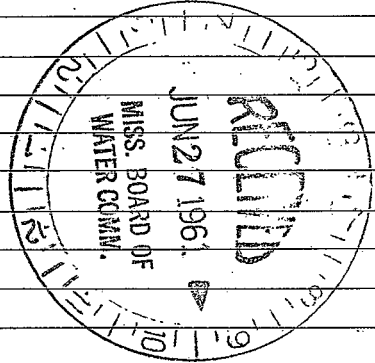

(Use Back Side)

Well No.

